



10641 Highway 36
Covington, GA
30014


www.sunbeltbuilders.com

t 770.786.3031
f 770.786.3046

JACKSON COUNTY AIRPORT TERMINAL BUILDING

TruTek Framing Systems
4001 Hwy 153
Greenville, SC 29611
ph: 864-704-9315
Dalton Parker
dparker@trutek-fs.com

05-3000 Structural Steel, Metal Decking & Truss
As-built

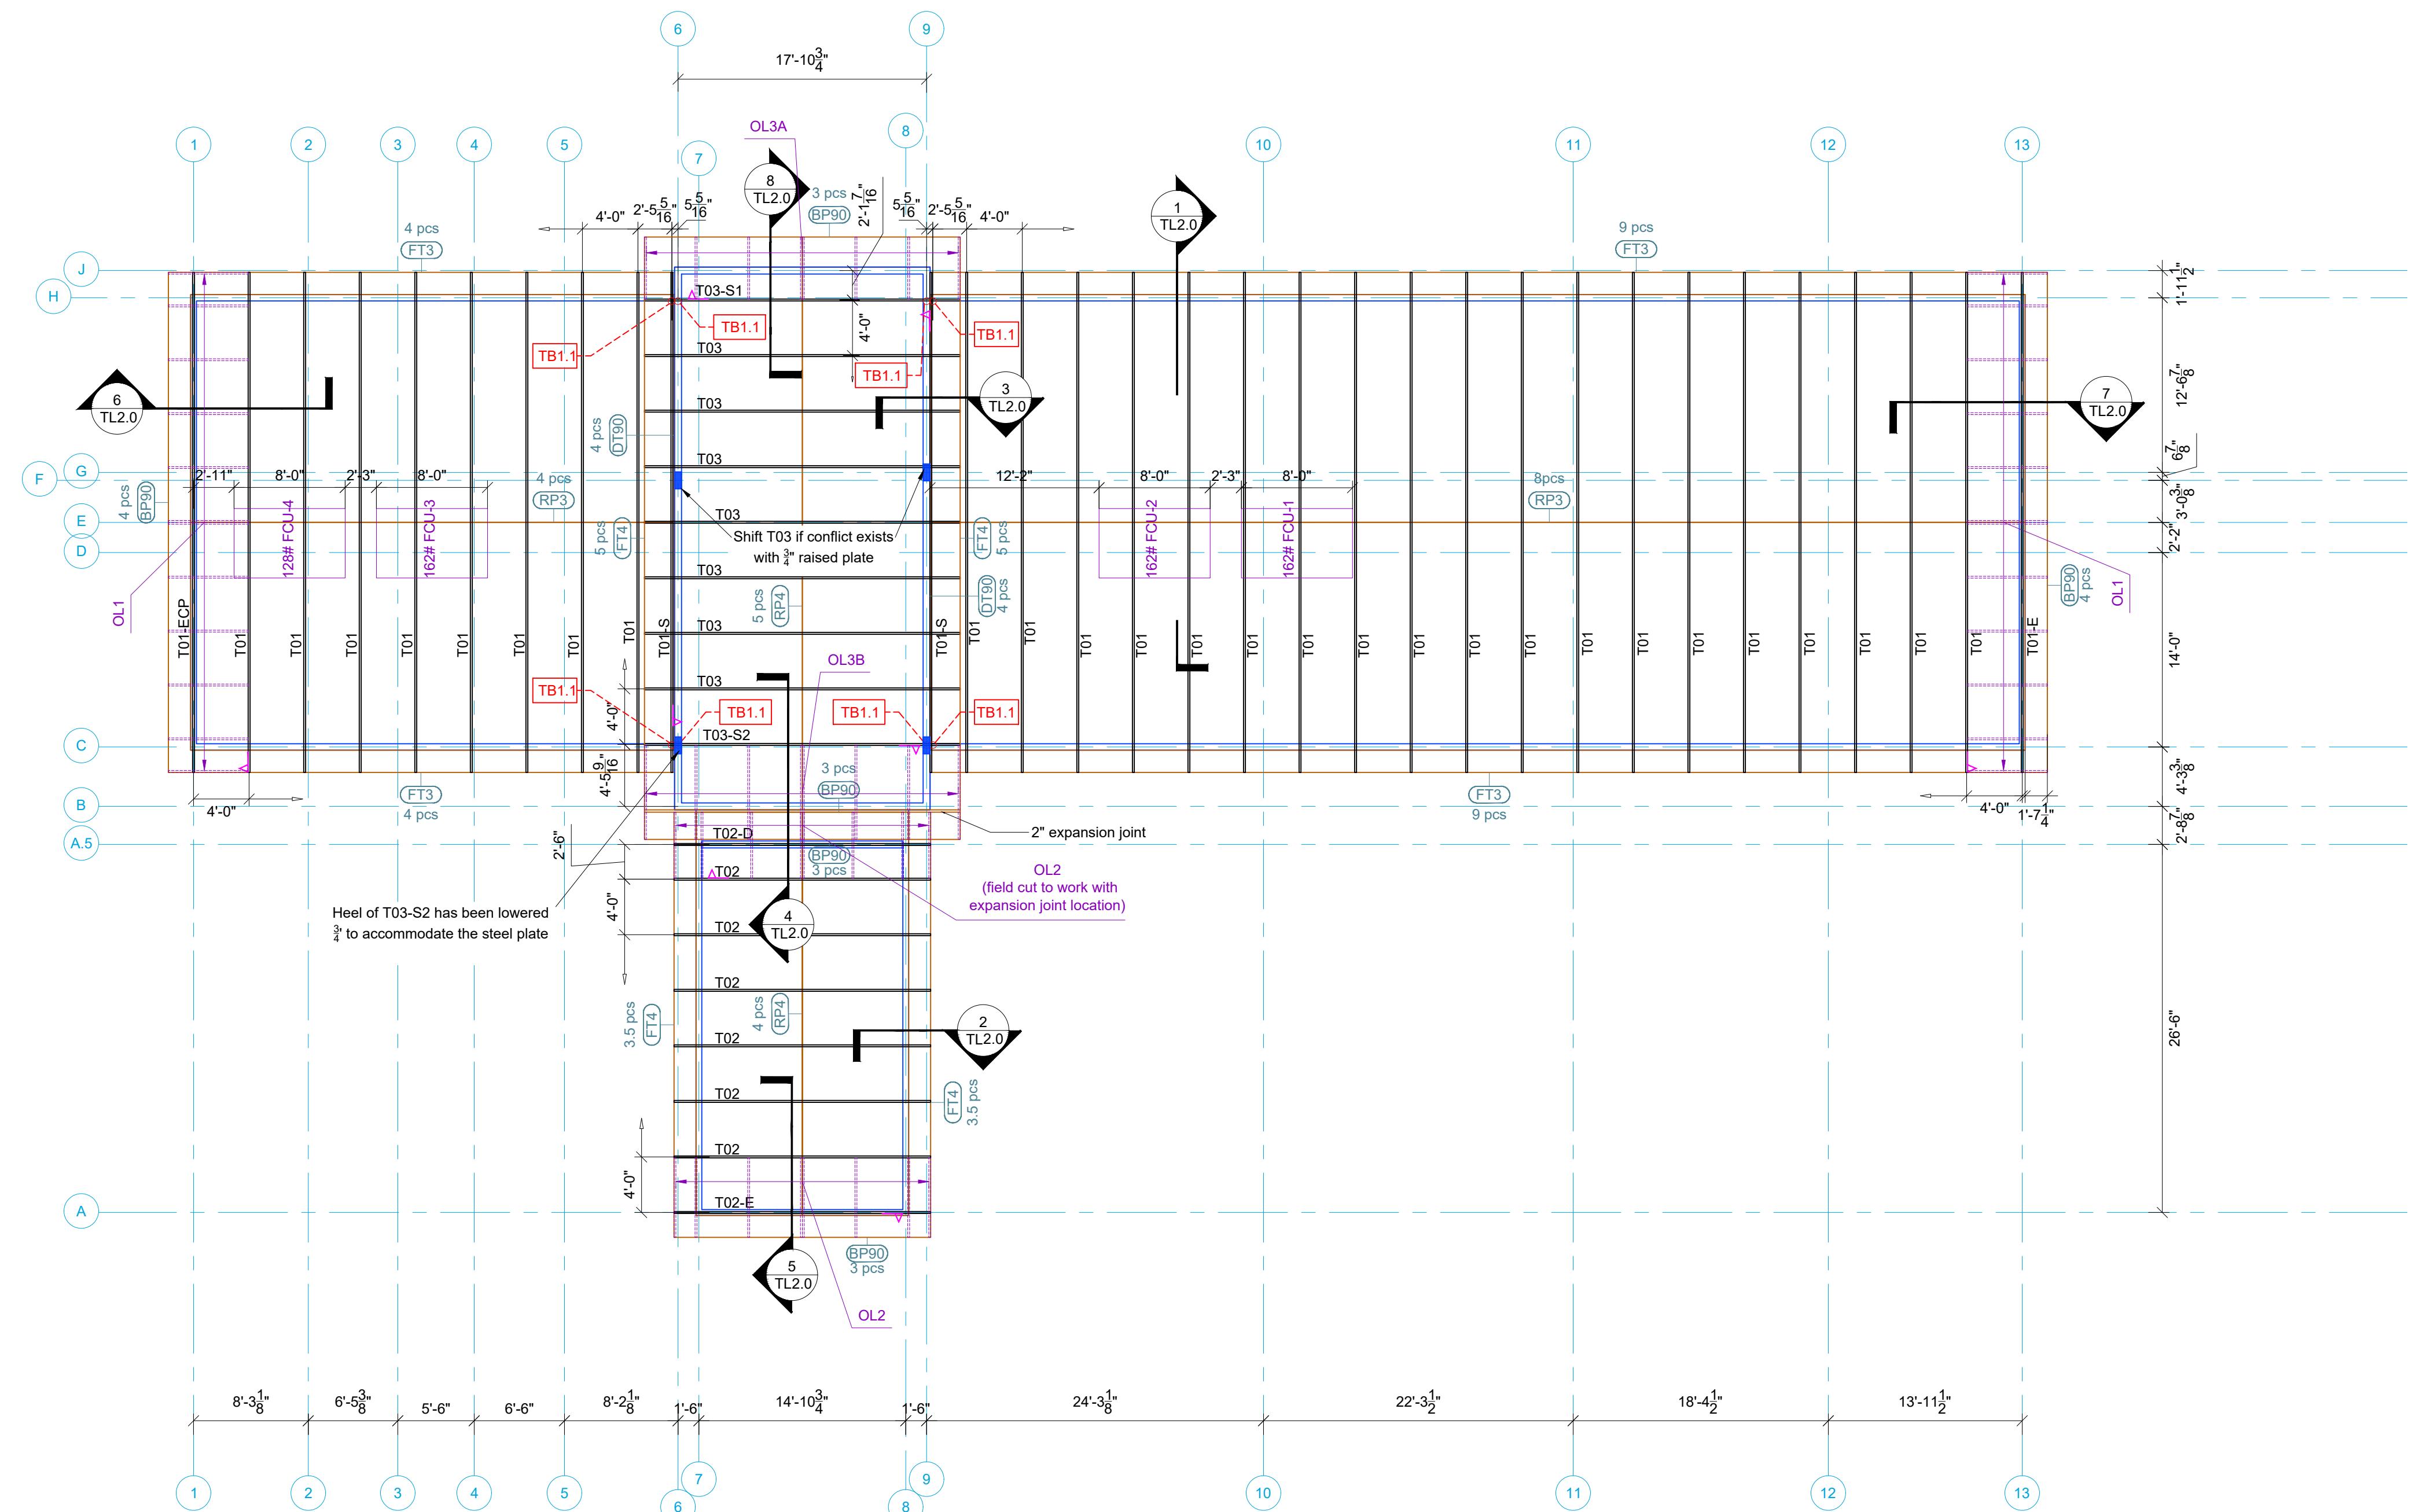

Truss Placement Plan

Structural Connection Information (see submittal book for details)

TB1.0 Typical truss to bearing connection U.N.O.

 = Direction of Hard Face

BENT PLATE SCHEDULE (figured with 6" overlaps)								
QTY	LABEL	Ga.	LENGTH	LEG (A)	LEG (B)	∠°	PROFILE	DESCRIPTION
12	RP3	14	10'-0"	4"	4"	152	^	Ridge
9	RP4	14	10'-0"	4"	4"	144	^	Ridge
17	FT4	14	10'-0"	3"	3"	72	∨	Fascia-Top
26	FT3	14	10'-0"	4"	4"	76	∨	Fascia-Top
21	BP90	14	10'-0"	3"	3"	90	L	Rake
8	DT90	14	10'-0"	4"	4"	90	L	Deflection Track
10	FP4	14	10'-0"	0"	0"	180		Flat Plate


Jackson County Airport Terminal

Jefferson, GA

Jefferson, GA

Trutek

Framing Systems LLC

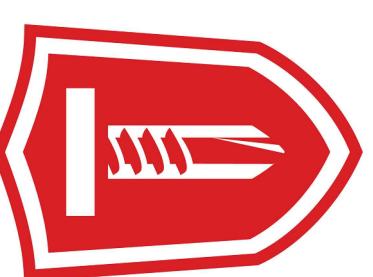

ISSUE DATE:

EVISIONS:

TruTek Job# 24188

PRINTED BY: ADT

APPROVED BY: JM

HEET:

TL1.0



Jackson County Airport Terminal

Jefferson, GA

LOCATION:

ISSUE DATE:

ONS:


TruTek Job# 34188



DRAWN BY: ADT

APPROVED BY: JM

HEET:

TL2.0

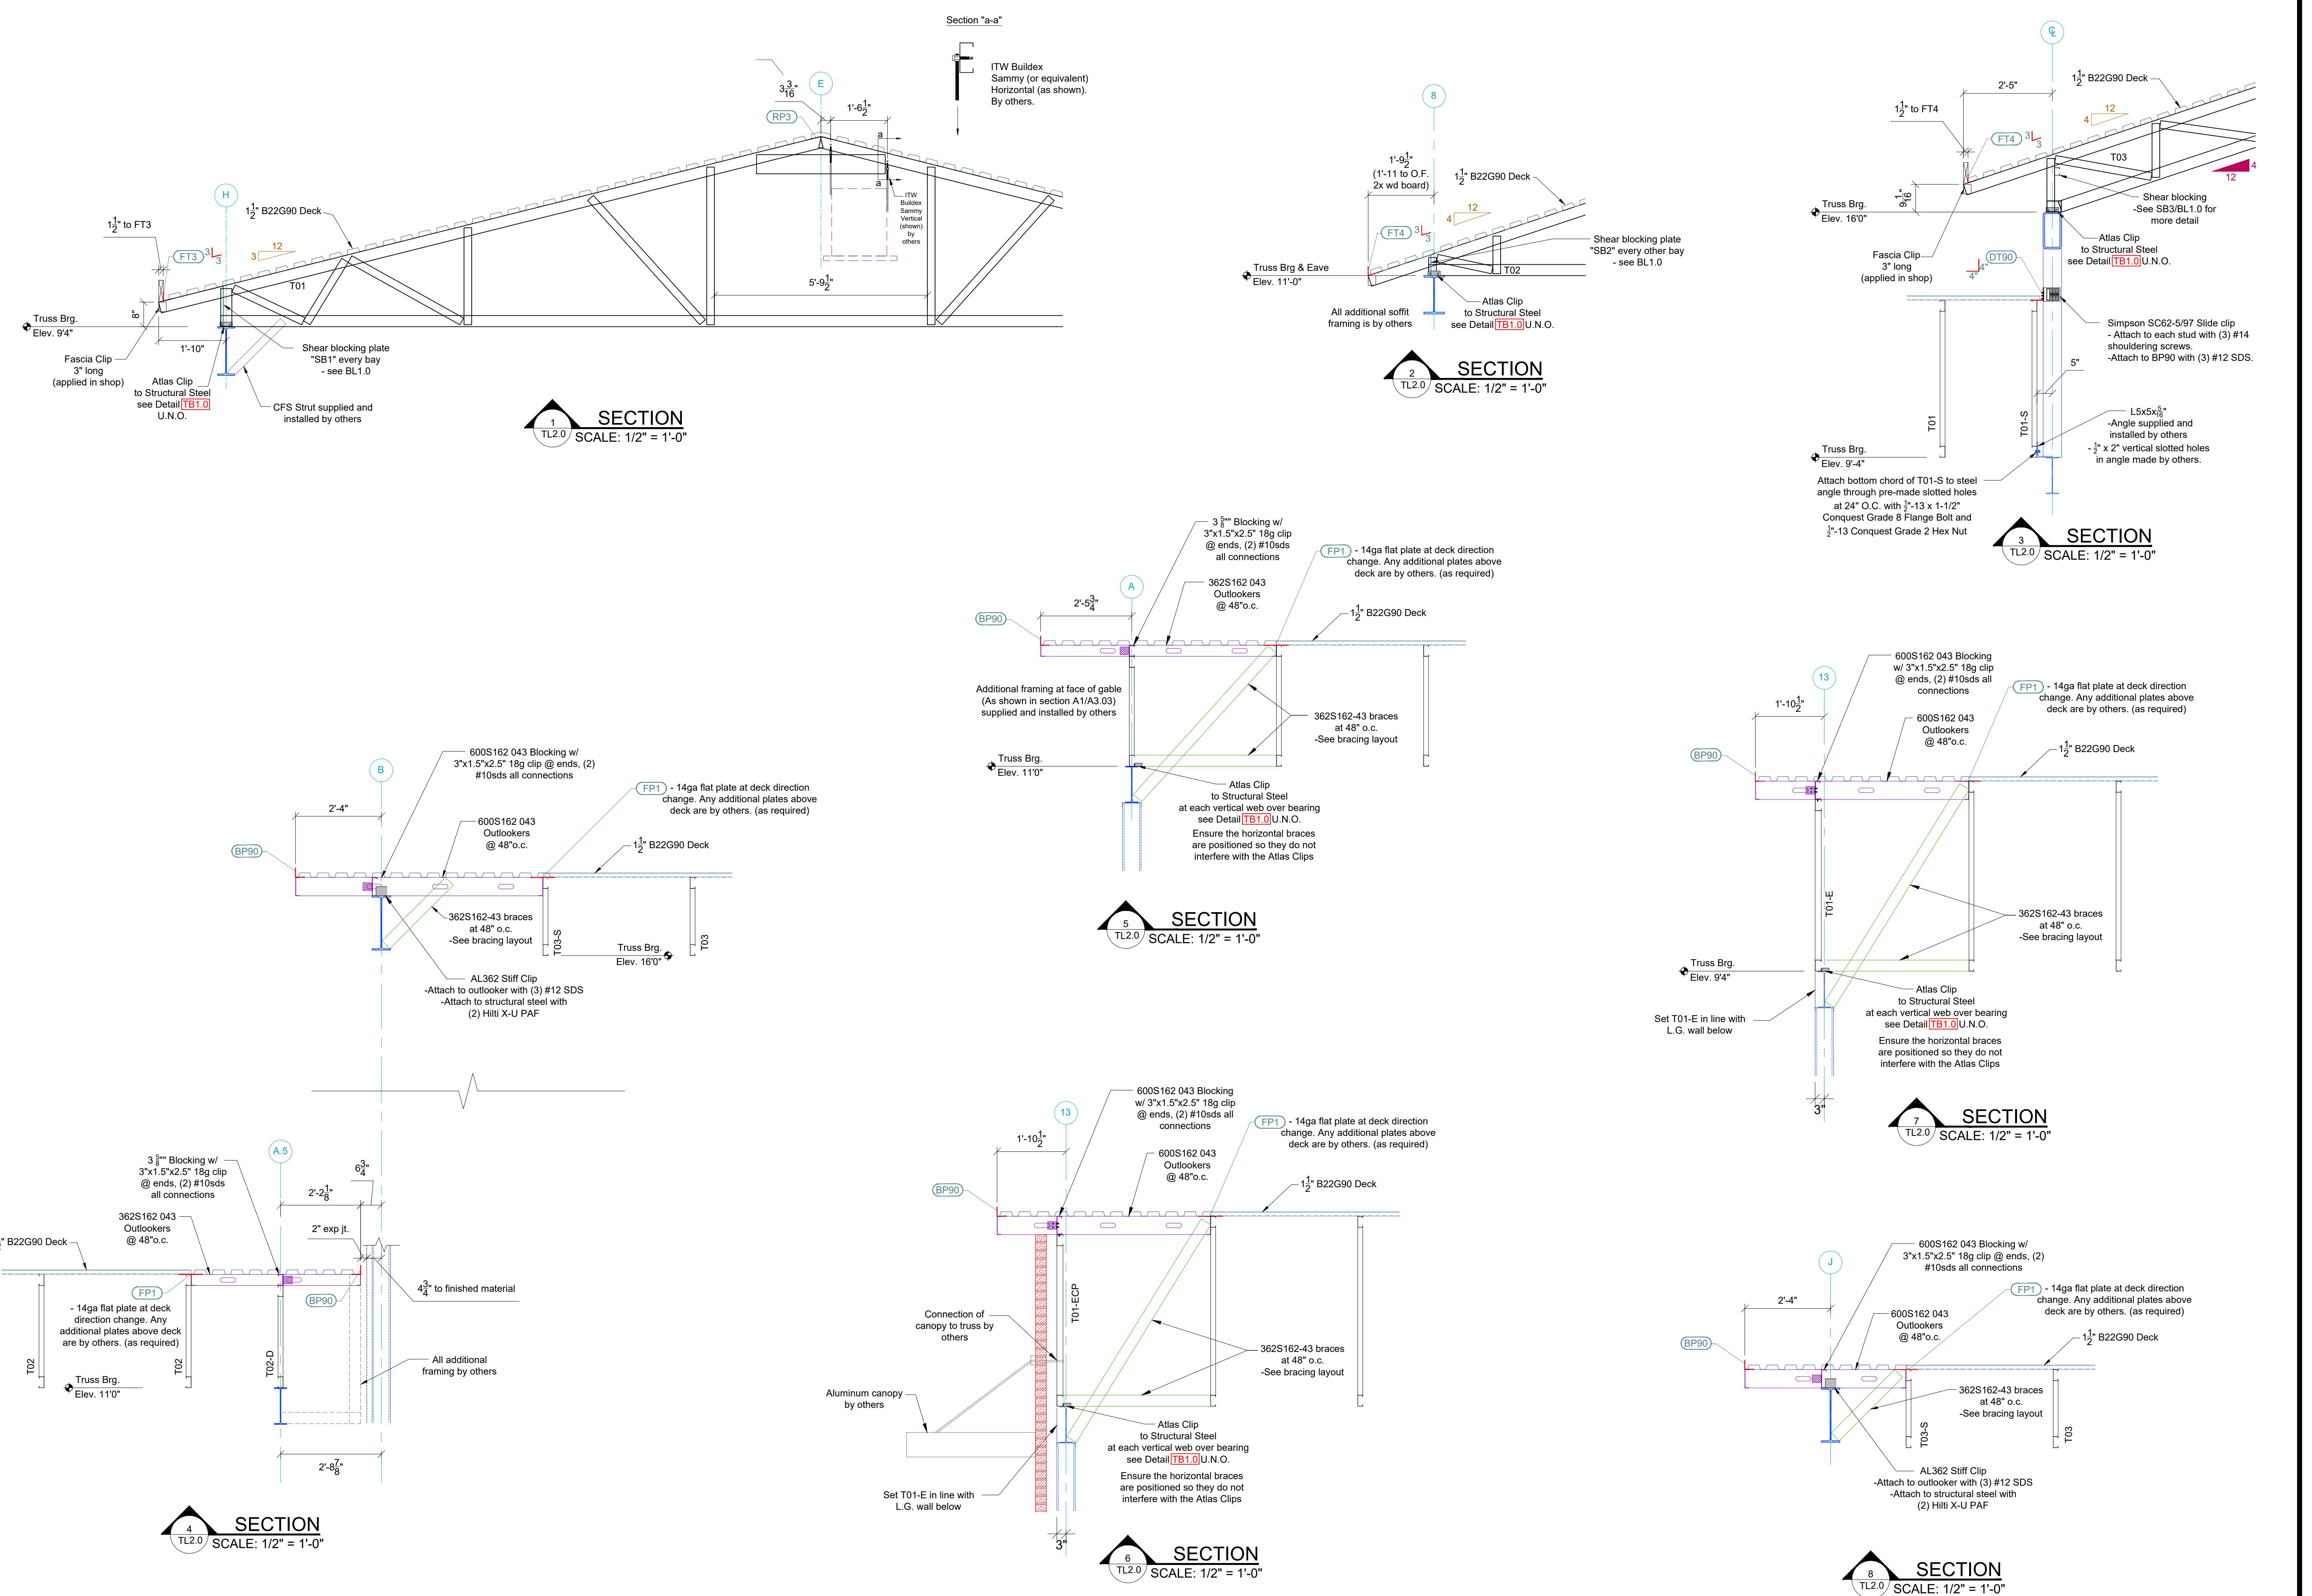

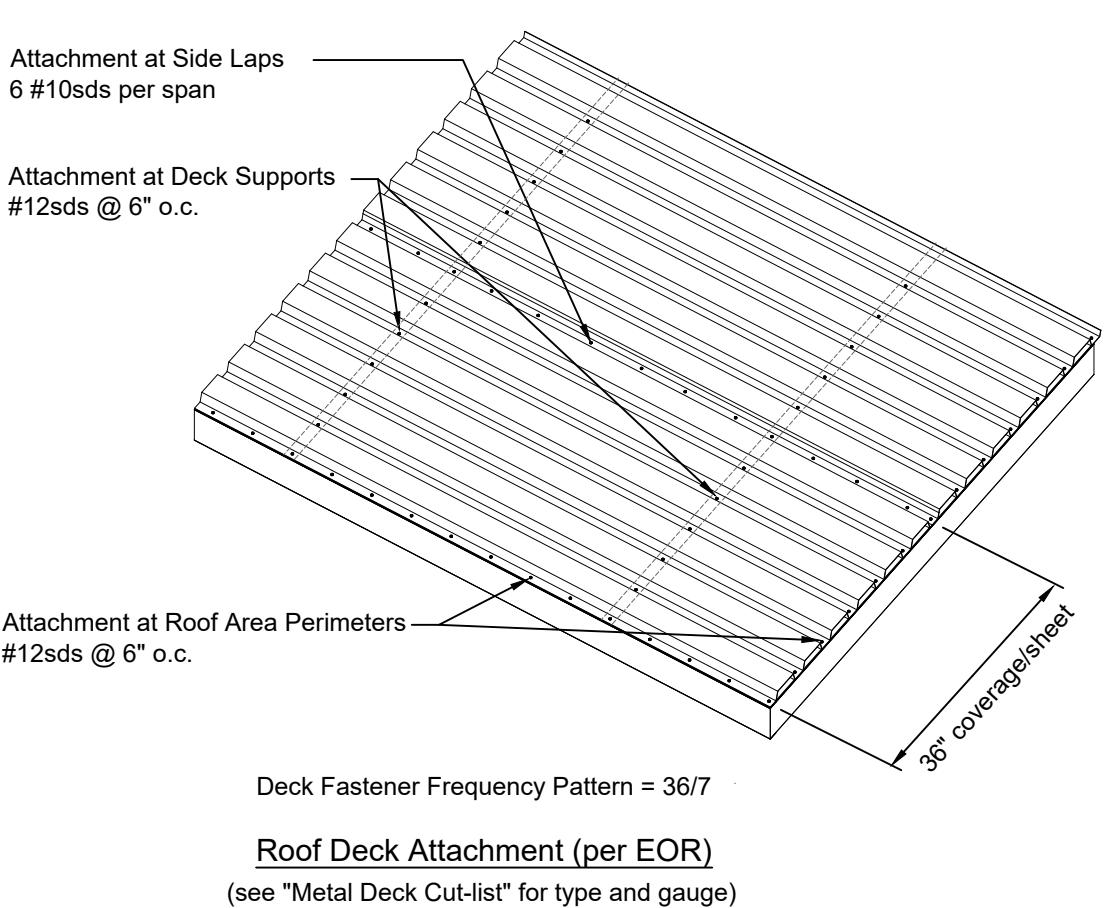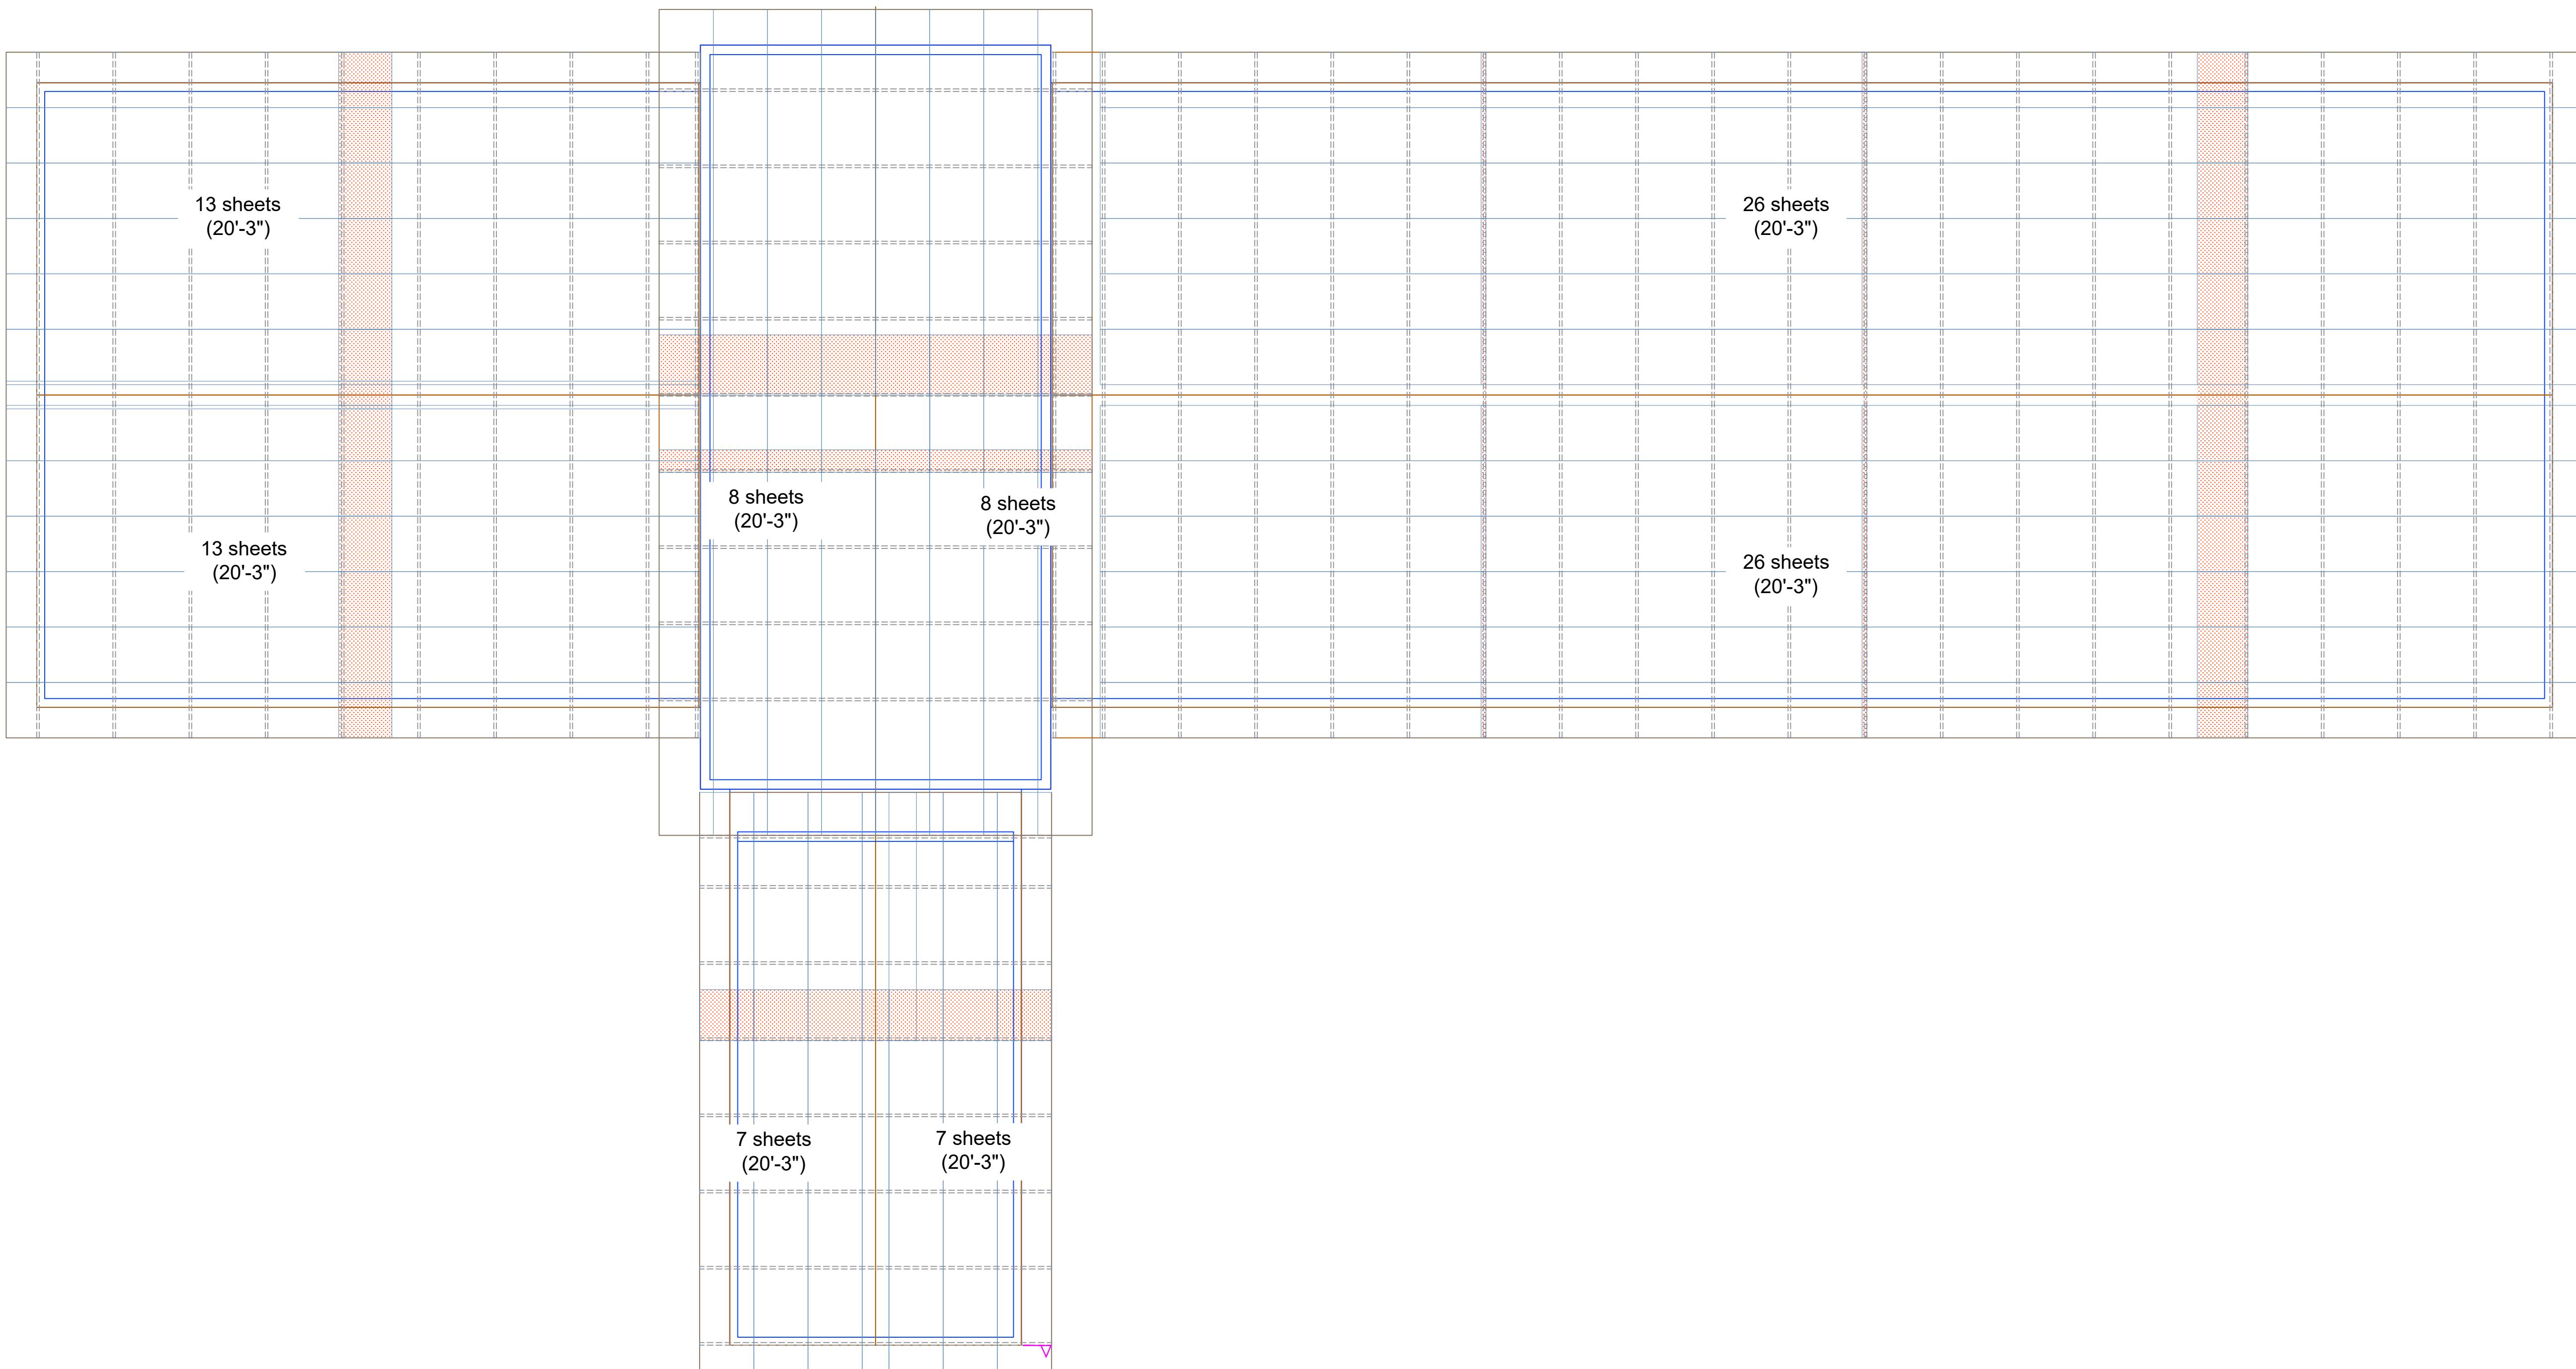

Metal Deck Layout Plan

All connections of Deck to roof framing to be per EOR's specifications.
(see Note F. under "Steel Roof Deck" notes on S0.03 summarized below)

#12sds at supports, #10sds at side laps (hex heads)

36/7 Pattern at supports, 6 connections per span at side laps, 6" o.c. at roof area edges. ▲

Metal Deck Cut-List						
QTY	Depth	Type	Ga.	Galv.	ksi	LENGTH
108	1.5"	B	22	G90	50	20'-3"

PAGE KEY	
SHEET OF METAL DECK	
TRUSS BELOW DECK	
SPLICE/END LAP OF METAL DECK (Splice Location For Illustration Purposes Only)	

Jackson County Airport Terminal
Jefferson, GA

JOB NAME:
LOCATION:



ISSUE DATE:
02/27/25

REVISIONS:

▲ 04/25/25


TruTek Job# 24188

DRAWN BY: ADT

APPROVED BY: JM

SHEET:

TL3.0

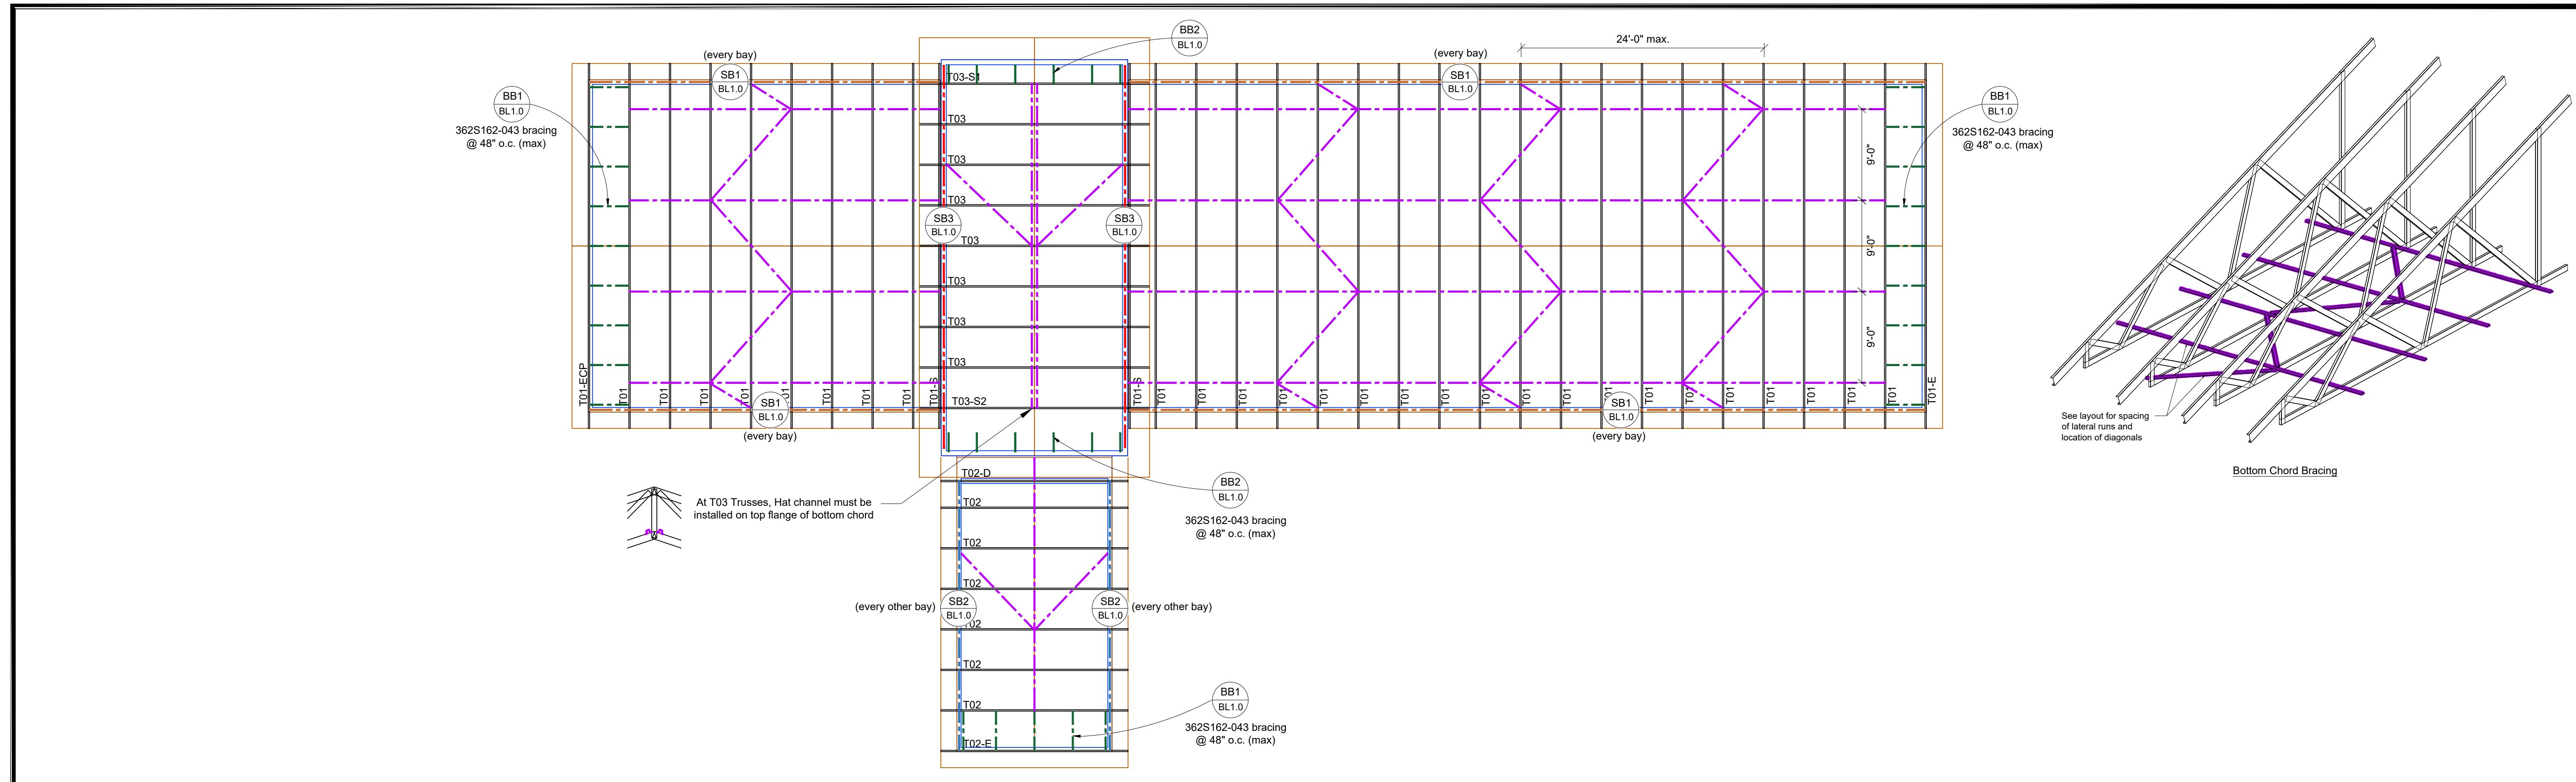

FULL MOON
ENGINEERING

Jackson County Airport Terminal
Jefferson, GA



ISSUE DATE:
02/27/25

REVISIONS:
04/25/25

TruTek Job# 24188

DRAWN BY: ADT


APPROVED BY: JM

SHEET:

BL1.0



2/28/2025

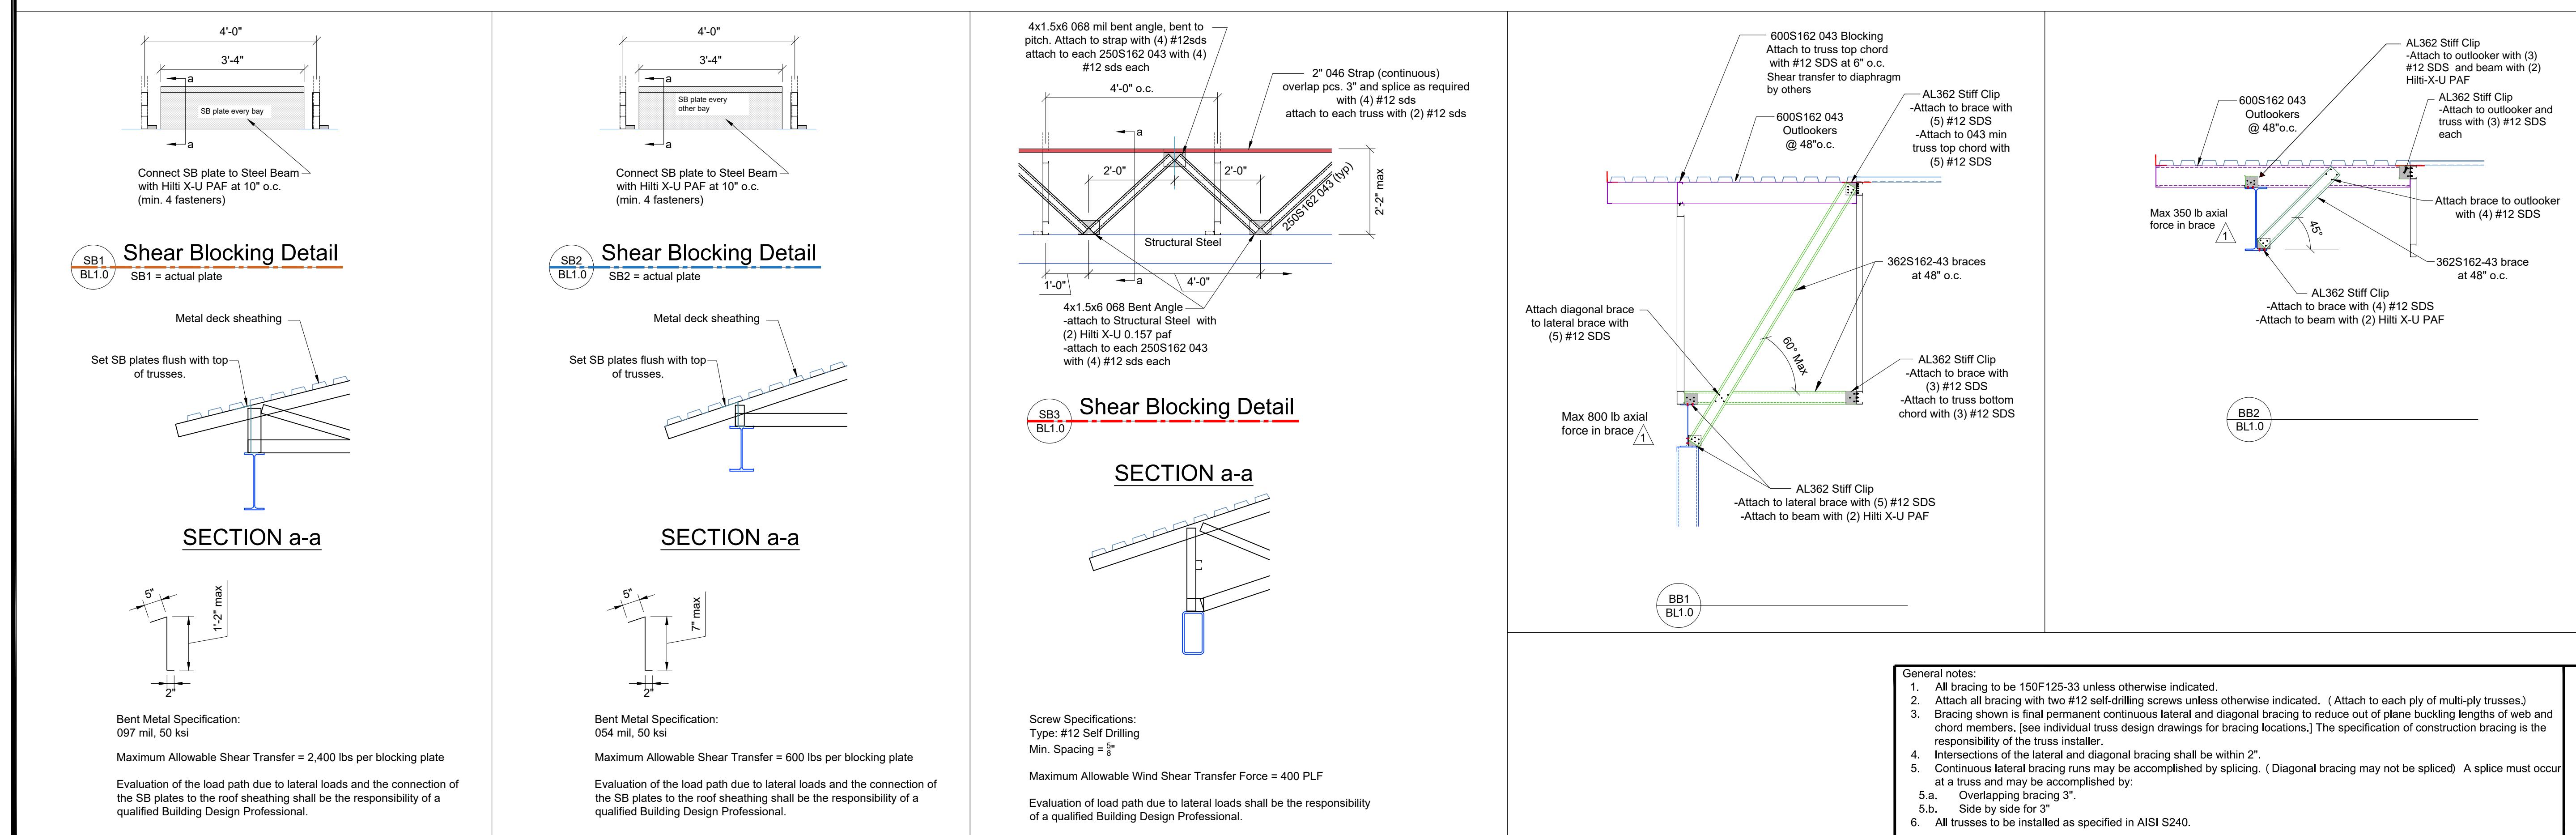

TruTek Framing Systems

 4001 Hwy 153
 Greenville, SC 29611
 864 999 2020

Truss:
T01

24188

JobID: Jackson County Airport

Date: 4/25/2025 12:37:52 PM

System: KeyTRUSS 6.113

Page: 2 of 2

Report: Eng Plot

SPAN	PITCH	QTY	OHL	OHR	PLYS	SPACING	WGT/PLY
32-7-10	3/12	27	1-8-4	1-8-4	1	48 in	223.3 lbs

User-defined Load Case W10: Beam_Brace_Right
Point Loads

Member	Location	Direction	Load	Trib Wdth
Bot	1-40	Right	566lbs	48 in
Bot	1-40	Up	566lbs	48 in
Bot	31-5-10	Right	566lbs	48 in
Bot	31-5-10	Down	566lbs	48 in

User-defined Load Case W11: Beam_Brace_Left
Point Loads

Member	Location	Direction	Load	Trib Wdth
Bot	1-40	Left	566lbs	48 in
Bot	1-40	Down	566lbs	48 in
Bot	31-5-10	Left	566lbs	48 in
Bot	31-5-10	Up	566lbs	48 in

Load Combinations

#	LoadCombo	Factor
1	D1	1.000
2	D2	1.000
3	D1+Lr1	1.000
4	D2+Lr1	1.000
5	D1+Sl	1.000
6	D1+S2	1.000
7	D1+S3	1.000
8	D1+S4	1.000
9	D2+Sl	1.000
10	D2+S2	1.000
11	D2+S3	1.000
12	D2+S4	1.000
13	D1+06W3	1.000
14	D1+06W8	1.000
15	D1+06W9	1.000
16	D1+06W10	1.000
17	D1+06W11	1.000
18	D2+06W3	1.000
19	D2+06W8	1.000
20	D2+06W9	1.000
21	D2+06W10	1.000
22	D2+06W11	1.000
23	D1+045W3+0.75Lr1	1.000
24	D1+045W10+0.75Lr1	1.000
25	D1+045W11+0.75Lr1	1.000
26	D2+045W3+0.75Lr1	1.000
27	D2+045W10+0.75Lr1	1.000
28	D2+045W11+0.75Lr1	1.000
29	D1+045W3+0.75Sl	1.000
30	D1+045W3+0.75S2	1.000
31	D1+045W3+0.75S3	1.000
32	D1+045W3+0.75S4	1.000
33	D1+045W10+0.75Sl	1.000
34	D1+045W10+0.75S2	1.000
35	D1+045W10+0.75S3	1.000
36	D1+045W10+0.75S4	1.000
37	D1+045W11+0.75Sl	1.000
38	D1+045W11+0.75S2	1.000
39	D1+045W11+0.75S3	1.000
40	D1+045W11+0.75S4	1.000
41	D2+045W3+0.75Sl	1.000
42	D2+045W3+0.75S2	1.000
43	D2+045W3+0.75S3	1.000
44	D2+045W3+0.75S4	1.000
45	D2+045W10+0.75Sl	1.000
46	D2+045W10+0.75S2	1.000
47	D2+045W10+0.75S3	1.000
48	D2+045W10+0.75S4	1.000
49	D2+045W11+0.75Sl	1.000
50	D2+045W11+0.75S2	1.000
51	D2+045W11+0.75S3	1.000
52	D2+045W11+0.75S4	1.000
53	06D1+06W1	1.000
54	06D1+06W2	1.000
55	06D1+06W4	1.000
56	06D1+06W10	1.000
57	06D1+06W11	1.000
58	06D2+06W1	1.000
59	06D2+06W2	1.000
60	06D2+06W4	1.000
61	06D2+06W10	1.000
62	06D2+06W11	1.000

Member Forces Summary

Table indicates: Member ID, max CSI, max axial force, (max comp force if different from max axial force)

TChd	22-1	0.088	581bs	(0lbs)	4-5	0.074	-9289lbs	8-9*	0.024	-8730lbs	12-13	0.080	-6682lbs	(0lbs)		
	1-2	0.088	-6682lbs	(0lbs)	5-6*	0.035	-8730lbs	9-10	0.074	-9289lbs	13-23	0.088	581bs	(0lbs)		
	2-3	0.070	-10090lbs	(0lbs)	6-7*	0.078	-389lbs	10-11	0.0673	-9969lbs						
	3-4	0.073	-9969lbs	(0lbs)	7-8*	0.078	-389lbs	11-12	0.0670	-10090lbs						
BChd	14-15*	0.104	340lbs	(-340lbs)	16-17	0.093	9,695lbs	(0lbs)	18-19	0.093	9,695lbs	(0lbs)	20-21*	0.112	679lbs	(-679lbs)
	15-16	0.172	8,135lbs	(0lbs)	17-18	0.024	8,876lbs	(0lbs)	19-20	0.172	8,134lbs	(0lbs)				
Webs	1-21	0.811	-4,797lbs	(0lbs)	3-19	0.067	-176lbs	(0lbs)	9-17	0.399	1,929lbs	(0lbs)	12-15	0.799	-3,092lbs	(0lbs)
	1-20	0.898	7,206lbs	(0lbs)	4-18	0.058	-1,275lbs	(0lbs)	10-17	0.058	-1,275lbs	(0lbs)	13-15	0.898	7,206lbs	(0lbs)
	2-20	0.799	-3,091lbs	(0lbs)	5-18	0.399	1,929lbs	(0lbs)	11-16	0.063	-167lbs	(0lbs)	13-14	0.811	-4,797lbs	(0lbs)
	2-19	0.369	1,786lbs	(-95lbs)	6-8	0.074	-8,616lbs	(0lbs)	12-16	0.369	1,786lbs	(-95lbs)				

Additional Notes:

The end of every chord segment shall be braced laterally perpendicular to the plane of the truss. Lateral braces shall be installed within 6 " of the end of each chord segment.

NOTE : Web crippling calculation assume truss is fastened to support.

** WARNING : Web crippling prevention device required!

TruTek Framing Systems

 4001 Hwy 153
 Greenville, SC 29611
 864 999 2020

Truss: T01-E

 JobName: 24188
 JobID: Jackson County Airport
 Date: 2/28/2025 6:50:46 AM
 System: KeyTRUSS 6.113
 Page: 2 of 2
 Report: Eng Plot

SPAN	PITCH	QTY	OHL	OHR	PLYS	SPACING	WGT/PLY
32-7-10	3/12	1	1-8-4	1-8-4	1	48 in	222.8 lbs

User-defined Load Case L2: Drag Left

Distributed Loads

Member	Location 1	Location 2	Direction	Spread	Start Load	End Load	Trib Width
Top	Cont		PLeft	Rake	300plf	300plf	
Bot	Cont		PRight	Rake	330plf	330plf	

Load Combinations

#	LoadCombo	Factor
1	D1	1.000
2	D1+L1	1.000
3	D1+L2	1.000
4	D1+Lr1	1.000
5	D1+S1	1.000
6	D1+S2	1.000
7	D1+S3	1.000
8	D1+S4	1.000
9	D1+0.75L1+0.75Lr1	1.000
10	D1+0.75L2+0.75Lr1	1.000
11	D1+0.75L1+0.75S1	1.000
12	D1+0.75L1+0.75S2	1.000
13	D1+0.75L1+0.75S3	1.000
14	D1+0.75L1+0.75S4	1.000
15	D1+0.75L2+0.75S1	1.000
16	D1+0.75L2+0.75S2	1.000
17	D1+0.75L2+0.75S3	1.000
18	D1+0.75L2+0.75S4	1.000
19	D1+0.6W3	1.000
20	D1+0.6W8	1.000
21	D1+0.6W9	1.000
22	D1+0.45W3+0.75L1+0.75Lr1	1.000
23	D1+0.45W3+0.75L2+0.75Lr1	1.000
24	D1+0.45W3+0.75L1+0.75S1	1.000
25	D1+0.45W3+0.75L1+0.75S2	1.000
26	D1+0.45W3+0.75L1+0.75S3	1.000
27	D1+0.45W3+0.75L1+0.75S4	1.000
28	D1+0.45W3+0.75L2+0.75S1	1.000
29	D1+0.45W3+0.75L2+0.75S2	1.000
30	D1+0.45W3+0.75L2+0.75S3	1.000
31	D1+0.45W3+0.75L2+0.75S4	1.000
32	06D1+06W1	1.000
33	06D1+06W2	1.000
34	06D1+06W4	1.000

Member Forces Summary

Table indicates Member ID, max CSI, max axial force, (max comp force if different from max axial force)										
TChd	35-1	0.183	591 lbs	(-546 lbs)	5-6	0.410	-1.952 lbs	10-11	0.290	1,068 lbs
	1-2	0.186	-1,494 lbs		6-7	0.232	-1.507 lbs	11-12	0.230	-1,493 lbs
	2-3	0.371	-2,089 lbs			1.081 lbs	(-1,072 lbs)	12-13	0.408	-1,938 lbs
	3-4	0.414	-2,587 lbs		8-9	0.141	-637 lbs	13-14	0.271	-2,095 lbs
	4-5	0.272	-2,109 lbs		9-10	0.140	-623 lbs	14-15	0.413	-2,573 lbs
BChd	18-19	0.111	-809 lbs		22-23	0.302	1,685 lbs	26-27	0.177	-662 lbs
	19-20	0.168	1,295 lbs	(-1,272 lbs)	23-24	0.282	-1,640 lbs	27-28	0.203	-960 lbs
	20-21	0.332	1,943 lbs	(-1,925 lbs)	24-25	0.205	-980 lbs	28-29	0.280	-1,620 lbs
	21-22	0.318	2,345 lbs	(-2,336 lbs)	25-26	0.179	-682 lbs	29-30	0.300	1,664 lbs
Wbs	1-34	0.256	-920 lbs		5-30	0.181	-1,230 lbs	10-25	0.072	-416 lbs
	1-33	0.184	1,386 lbs	(-1,272 lbs)	5-29	0.207	-1,363 lbs	11-25	0.183	-1,079 lbs
	2-33	0.152	-1,096 lbs		6-29	0.059	-390 lbs	11-24	0.154	-948 lbs
	2-32	0.228	-1,599 lbs		7-28	0.154	-948 lbs	12-23	0.059	-390 lbs
	3-32	0.230	-1,631 lbs		7-27	0.183	-1,078 lbs	13-23	0.207	-1,363 lbs
	3-31	0.230	-1,592 lbs		8-27	0.072	-416 lbs	13-22	0.181	-1,230 lbs
	4-31	0.046	-318 lbs		9-26	0.044	-232 lbs	14-21	0.046	-318 lbs

Additional Notes:

The end of every chord segment shall be braced laterally perpendicular to the plane of the truss. Lateral braces shall be installed within 6" of the end of each chord segment.

NOTE: Web crippling calculation assume truss is fastened to support.

TruTek Framing Systems

 4001 Hwy 153
 Greenville, SC 29611
 864 999 2020

 Truss: T01-ECP
 JobName: 24188
 JobID: Jackson County Airport
 Date: 2/28/2025 6:51:06 AM
 System: KeyTRUSS 6.113
 Page: 2 of 2
 Report: Eng Plot

SPAN	PITCH	QTY	OHL	OHR	PLYS	SPACING	WGT/PLY
32-7-10	3/12	1	1-8-4	1-8-4	1	48 in	222.8 lbs

User-defined Load Case L2: Drag Left

Distributed Loads

Member	Location 1	Location 2	Direction	Spread	Start Load	End Load	Trib Width
Top	Cont		PLeft	Rake	300plf	300plf	
Bot	Cont		PRight	Rake	330plf	330plf	

Load Combinations

#	LoadCombo	Factor
1	D1	1.000
2	D1+L1	1.000
3	D1+L2	1.000
4	D1+Lr1	1.000
5	D1+S1	1.000
6	D1+S2	1.000
7	D1+S3	1.000
8	D1+S4	1.000
9	D1+0.75L1+0.75Lr1	1.000
10	D1+0.75L2+0.75Lr1	1.000
11	D1+0.75L1+0.75S1	1.000
12	D1+0.75L1+0.75S2	1.000
13	D1+0.75L1+0.75S3	1.000
14	D1+0.75L1+0.75S4	1.000
15	D1+0.75L2+0.75S1	1.000
16	D1+0.75L2+0.75S2	1.000
17	D1+0.75L2+0.75S3	1.000
18	D1+0.75L2+0.75S4	1.000
19	D1+0.6W3	1.000
20	D1+0.6W8	1.000
21	D1+0.6W9	1.000
22	D1+0.45W3+0.75L1+0.75Lr1	1.000
23	D1+0.45W3+0.75L2+0.75Lr1	1.000
24	D1+0.45W3+0.75L1+0.75S1	1.000
25	D1+0.45W3+0.75L1+0.75S2	1.000
26	D1+0.45W3+0.75L1+0.75S3	1.000
27	D1+0.45W3+0.75L1+0.75S4	1.000
28	D1+0.45W3+0.75L2+0.75S1	1.000
29	D1+0.45W3+0.75L2+0.75S2	1.000
30	D1+0.45W3+0.75L2+0.75S3	1.000
31	D1+0.45W3+0.75L2+0.75S4	1.000
32	06D1+06W1	1.000
33	06D1+06W2	1.000
34	06D1+06W4	1.000

Member Forces Summary

Table indicates Member ID, max CS, max axial force, (max comp force if different from max axial force)										
TChd	35-1	0.183	591 lbs	(-546 lbs)	5-6	0.410	-1.952 lbs	10-11	0.290	1,068 lbs
	1-2	0.186	-1,494 lbs		6-7	0.232	-1.507 lbs	11-12	0.230	-1,493 lbs
	2-3	0.371	-2,089 lbs			1.081 lbs	(-1,072 lbs)	12-13	0.408	-1,938 lbs
	3-4	0.414	-2,587 lbs		8-9	0.141	-637 lbs	13-14	0.271	-2,095 lbs
	4-5	0.272	-2,109 lbs		9-10	0.140	-623 lbs	14-15	0.413	-2,573 lbs
BChd	18-19	0.111	-809 lbs		22-23	0.302	1,685 lbs	26-27	0.177	-662 lbs
	19-20	0.168	1,295 lbs	(-1,272 lbs)	23-24	0.282	-1,640 lbs	27-28	0.203	-960 lbs
	20-21	0.332	1,943 lbs	(-1,925 lbs)	24-25	0.205	-980 lbs	28-29	0.280	-1,620 lbs
	21-22	0.318	2,345 lbs	(-2,336 lbs)	25-26	0.179	-682 lbs	29-30	0.300	1,664 lbs
Wbs	1-34	0.256	-920 lbs		5-30	0.181	-1,230 lbs	10-25	0.072	-416 lbs
	1-33	0.184	1,386 lbs	(-1,272 lbs)	5-29	0.207	-1,363 lbs	11-25	0.183	-1,079 lbs
	2-33	0.152	-1,096 lbs		6-29	0.059	-390 lbs	11-24	0.154	-948 lbs
	2-32	0.228	-1,599 lbs		7-28	0.154	-948 lbs	12-23	0.059	-390 lbs
	3-32	0.230	-1,631 lbs		7-27	0.183	-1,078 lbs	13-23	0.207	-1,363 lbs
	3-31	0.230	-1,592 lbs		8-27	0.072	-416 lbs	13-22	0.181	-1,230 lbs
	4-31	0.046	-318 lbs		9-26	0.044	-232 lbs	14-21	0.046	-318 lbs

Additional Notes:

The end of every chord segment shall be braced laterally perpendicular to the plane of the truss. Lateral braces shall be installed within 6" of the end of each chord segment.

NOTE : Web crippling calculation assume truss is fastened to support.

TruTek Framing Systems

 4001 Hwy 153
 Greenville, SC 29611
 864 999 2020

Truss: T01-S

 24188
 JobID: Jackson County Airport
 Date: 2/27/2025 10:06:50 AM
 System: KeyTRUSS 6.113
 Page: 2 of 2
 Report: Eng Plot

SPAN	PITCH	QTY	OHL	OHR	PLYS	SPACING	WGT/PLY
32-7-10	3/12	2	1-8-4	1-8-4	1	36 in	149.5 lbs
9	D1+06 W9			1.000			
10	D1+06 W10			1.000			
11	D1+06 W11			1.000			
12	D1+045 W3+0.75 Lrl			1.000			
13	D1+045 W10+0.75 Lrl			1.000			
14	D1+045 W11+0.75 Lrl			1.000			
15	D1+045 W3+0.75 Sl			1.000			
16	D1+045 W3+0.75 Sl			1.000			
17	D1+045 W3+0.75 Sl			1.000			
18	D1+045 W3+0.75 Sl			1.000			
19	D1+045 W10+0.75 Sl			1.000			
20	D1+045 W10+0.75 Sl			1.000			
21	D1+045 W10+0.75 Sl			1.000			
22	D1+045 W10+0.75 Sl			1.000			
23	D1+045 W11+0.75 Sl			1.000			
24	D1+045 W11+0.75 Sl			1.000			
25	D1+045 W11+0.75 Sl			1.000			
26	D1+045 W11+0.75 Sl			1.000			
27	06D1+06 W1			1.000			
28	06D1+06 W2			1.000			
29	06D1+06 W4			1.000			
30	06D1+06 W10			1.000			
31	06D1+06 W11			1.000			

Member Forces Summary

Table indicates: Member ID, max CS, max axial force, (max comp force if different from max axial force)

TChd	23-1	0.158	699 lbs	(-672 lbs)	3-4	0.947	-6341 lbs	6-7	0.97	-4034 lbs	9-10	0.758	-5565 lbs	
	1-2	0.899	-3969 lbs		4-5	0.755	-5382 lbs	7-8	0.757	-5381 lbs	10-11	0.898	-3961 lbs	
	2-3	0.754	-5572 lbs		5-6	0.599	-4034 lbs	8-9	0.951	-6332 lbs	11-24	0.158	699 lbs	
	12-13	0.247	748 lbs	(-748 lbs)	15-16	0.581	5431 lbs	18-19	0.535	4962 lbs	21-22	0.351	-1376 lbs	
BChd	13-14	0.692	3887 lbs	(-1,329 lbs)	16-17	0.454	4453 lbs	(-327 lbs)	19-20	0.614	4824 lbs	(-961 lbs)		
	14-15	0.664	5289 lbs	(-1,581 lbs)	17-18	0.408	3984 lbs	(0 lbs)	20-21	0.642	3425 lbs	(-7141 lbs)		
Webs	1-22	0.430	-3,374 lbs		4-19	0.255	630 lbs	(-622 lbs)	7-16	0.188	720 lbs	(-356 lbs)	10-13	0.887
	1-21	0.642	5,149 lbs	(-2,464 lbs)	4-18	0.679	-975 lbs		8-16	0.679	-975 lbs		11-13	0.640
	2-21	0.888	-2,601 lbs		5-18	0.187	718 lbs	(-354 lbs)	8-15	0.256	632 lbs	(-623 lbs)	11-12	0.430
	2-20	0.531	2,568 lbs	(-1,358 lbs)	5-17	0.953	-1,108 lbs		9-15	0.729	1,603 lbs	(-1,222 lbs)		
	3-20	0.480	-1,342 lbs		6-17	0.275	1,332 lbs	(0 lbs)	9-14	0.481	-1,346 lbs			
	3-19	0.724	1,596 lbs	(-1,215 lbs)	7-17	0.955	-1,110 lbs		10-14	0.532	2,571 lbs	(-1,363 lbs)		

Additional Notes:

The end of every chord segment shall be braced laterally perpendicular to the plane of the truss. Lateral braces shall be installed within 6" of the end of each chord segment.
 NOTE : Web crippling calculation assume truss is fastened to support.

SPAN 15-2-4	PITCH 4/12	QTY 6	OHL 1-7-12	OHR 1-7-12	PLYS 1	SPACING 48 in	WGT/PLY 45 lbs
1-7-12 0-6-9	1-10-3 1-10-3	5-8-14 7-7-2	3-0-15	5-8-14 13-4-0	1-10-3 15-2-4	1-7-12 0-6-9	

KTP6-54
3

4 1/2

12 1/4

1 2 3 4 5 6 7 8 9 10 11 12

0-0-0 1-10-3 1-10-3 5-8-14 7-7-2 5-8-14 13-4-0 1-10-3 15-2-4 0-0-0

Guidelines indicate fastener count in inches. Fastener count indicates the number of fasteners required. Where connection plates are called out on this drawing, a plate is required. Refer to General Notes for further clarifications. Allowable shear fastener spacing is calculated per the AISI S100. Maintain fastener edge margin at 9/16" max for each sheet of steel connected.

CSI Summary

CSI Summary	Deflection	L	(in)	Allowable
TC: 1004(3-4)	TL: 026in	L/ 685	(2-3)	L/ 240
BC: 0640(7-8)	LL: 013in	L/ 946	(2-3)	L/ 360
Web: 0408(5-6)	Can/ OHFL: 004in	2L/ 946	12	2L/ 180
	Can/ OHFL: 02in	2L/ 999	12	2L/ 180
	Hoz TL: 005in		2	

Reaction Summary

Reaction Summary		BrgCombo	BrgWidth	MaxReact	GravUplift	MWFRSUplift	MaxUplift	MaxHoriz
10	Pin(WL)	1	.35in	1,450lbs				80lbs
6	Pin(WL)	1	.25in	1,450lbs				

Material Summary

Material Summary	TChd Bracing: Sheathed
TChd	362S162-43 (50ks)
BChd	362S162-33 (50ks)
Webs	250S162-33 (50ks)

Loads Summary

Loads Summary

- 1) This truss has been designed in accordance with IBC - 2018.
- 2) This truss has been designed for the effects due to standard loading of TC Live = 20 psf; TC Dead = 12 psf; BC Live = 0 psf; BC Dead = 8 psf at 48 ioc.
- 3) This truss has been designed for the effects due to wind loads in accordance with ASCE7 - 16, $V = 110$ mph, Exposure C. The building is Gable with Risk Category II, Mean Roof Height 15 ft, Overall Building Dimensions of 67 ft x 131 ft, Enclosure Class: Enclosed, CC Zone Width 6 ft The left end vertical has been exposed to wind. The right end vertical has been exposed to wind. This truss is not an End Zone Truss. This truss is in a Hurricane Prone Region.
- 4) This truss has been designed for the effects of balanced and unbalanced snow loads in accordance with ASCE7 - 16, using a ground snow load of 5 psf and terrain category B. The exposure condition is Fully Exposed. The thermal condition is All Others ($C_t = 1.0$) with building category II ($I = 1.0$). The roof ventilation is Unknown with Roof R-Value Unknown. The roof slope is 4/12 and the surface type is All Others. This truss has not been designed to account for the effects of ice dams forming at the eaves.

GUSSET PLATES

Member Forces Summary


Additional Notes:

The end of every chord segment shall be braced laterally perpendicular to the plane of the truss. Lateral braces shall be installed within 6" of the end of each chord segment. NOTE: Web crippling calculation assume truss is fastened to support.



2/28/2025

SPAN 14-6-11	PITCH 4/12	QTY 1	OHL 1-0-0	OHR 1-0-0	PLYS 1	SPACING 48 in	WGT/PLY 35.2 lbs
-----------------	---------------	----------	--------------	--------------	-----------	------------------	---------------------

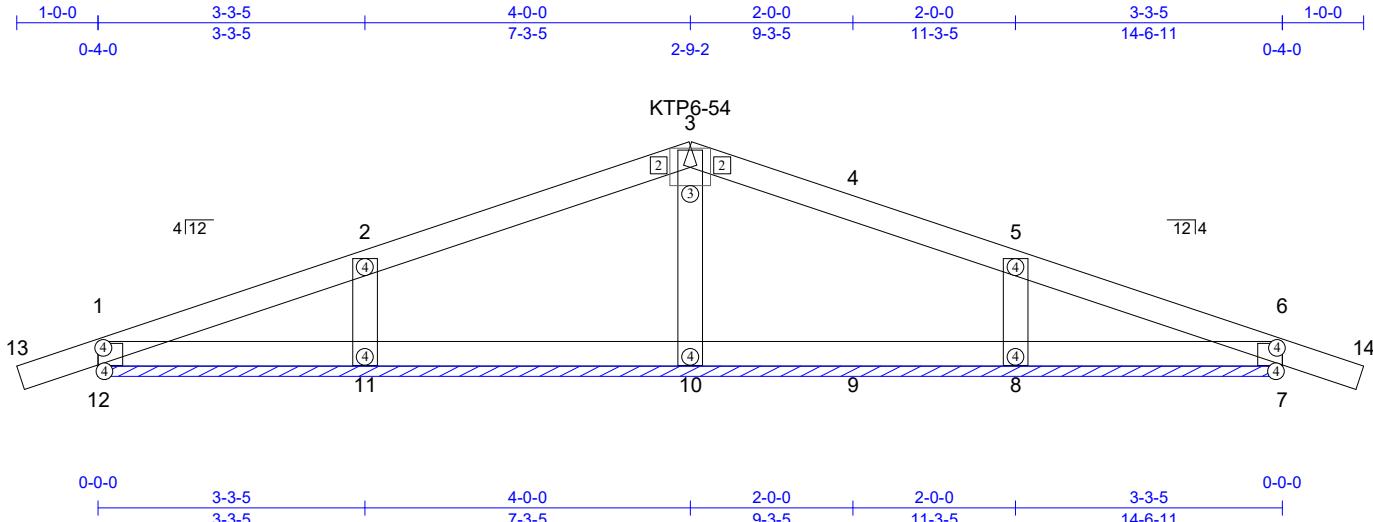

Circle indicates fastener count in web. Squares indicate fastener count in a loaded fastener. The number of 10 SDSS (AS) fasteners required for each end of the member. Each value indicates the number of fasteners required. Where connection plates are called out on this drawing, a plate is required. Refer to General Notes for further callout. Allowing shear, fastener is calculated as $\frac{1}{2} \times \text{AS} \times 100$. Minimum fastener size is 9/16" min for each sheet of connected.

CSI Summary

CSI Summary	Definition	Ex.	(loc)	Answer
TC : 0405 (2-3)	TL: 003 in	L/ 999	(2-3)	L/240
BC : 0093 (8-10)	LL: 002 in	L/ 999	(2-3)	L/360
Web: 0.181 (2-II)	Cant/ OHTL: 0in	2L/ 999	13	2L/ 180
	Cant/ OHLL: 0in	2L/ 999	13	2L/ 180
	Hzr TI: 0in		14	

Reaction Summary

Reaction Summary		BrgCombo	BrgWidth	Max React	Grav Uplift	MWFRSUplift	MaxUplift	MaxHoriz
7	HRoll(WL)	1	174.688 in	369 lbs				
8	HRoll(WL)	1	174.688 in	674 lbs				
10	HRoll(WL)	1	174.688 in	543 lbs				
11	HRoll(WL)	1	174.688 in	674 lbs				
12	Pn(WL)	1	174.688 in	369 lbs		-3 lbs	-3 lbs	-66 lbs

GUSSET PLATES

Material Summary

TChd	362SI62-33 (50ksi)	TChd Bracing: 48in
BChd	362SI62-33 (50ksi)	BChd Bracing: 108in
Webs	362SI62-33 (50ksi)	

Loads Summary

- 1) This truss has been designed in accordance with IBC - 2018.
- 2) This truss has been designed for the effects due to standard loading of TC Live = 20 psf; TC Dead = 12 psf; BC Live = 0 psf; BC Dead = 8 psf at 48 ioc.
- 3) This truss has been designed for the effects due to wind loads in accordance with ASCE7 - 16, V = 110 mph, Exposure C. The building is Gable with Risk Category II, Mean Roof Height 15 ft, Overall Building Dimensions of 67 ft x 131 ft, Enclosure Class: Enclosed, CC Zone Width 6 ft. The left end vertical has been exposed to wind. The right end vertical has been exposed to wind. This truss is not an End Zone Truss. This truss is in a Hurricane Prone Region.
- 4) This truss has been designed for the effects of balanced and unbalanced snow loads in accordance with ASCE7 - 16, using a ground snow load of 5 psf and terrain category B. The exposure condition is Fully Exposed. The thermal condition is All Others (Ct = 1.0) with building category II (I = 1.0). The roof ventilation is Unknown with Roof R-Value Unknown. The roof slope is 4/12 and the surface type is All Others. This truss has not been designed to account for the effects of ice dams forming at the eaves.

Member Forces Summary

Member Forces Summary		Table indicates member ID, member CS, member axial force, (max compression in member nominal diameter in kips)										
TChd	1-3 1-2	0.181 0.369	48lbs -71lbs	(0lbs)	2-3 3-5	0.405 0.405	159lbs 156lbs	(-118lbs) (-118lbs)	5-6 6-14	0.369 0.181	-71lbs 48lbs	(0lbs)
BChd	7-8	0.081	94lbs	(-20lbs)	8-10	0.093	94lbs	(-20lbs)	10-11	0.093	94lbs	(-20lbs)
Webs	1-12 2-11	0.134 0.194	-318lbs 559lbs		3-10 5-8	0.144 0.188	-410lbs 560lbs		6-7	0.134	-318lbs	

Additional Notes

The end of every chord segment shall be braced laterally perpendicular to the plane of the truss. Lateral braces shall be installed within 6 " of the end of each chord segment.
NOTE : Web crippling calculation assumes truss is fastened to support.



2/28/2025

TruTek Framing Systems

 4001 Hwy 153
 Greenville, SC 29611
 864 999 2020

Truss: T02-E

 JobName: 24188
 JobID: Jackson County Airport
 Date: 2/27/2025 10:06:52 AM
 System: KeyTRUSS 6.113
 Page: 2 of 2
 Report: Eng Plot

SPAN	PITCH	QTY	OHL	OHR	PLYS	SPACING	WGT/PLY
14-6-11	4/12	1	1-0-0	1-0-0	1	48 in	40.6 lbs
3	D1+L2			1.000			
4	D1+Lr1			1.000			
5	D1+S1			1.000			
6	D1+S2			1.000			
7	D1+S3			1.000			
8	D1+075L1+075Lr1			1.000			
9	D1+075L2+075Lr1			1.000			
10	D1+075L1+075S1			1.000			
11	D1+075L1+075S2			1.000			
12	D1+075L1+075S3			1.000			
13	D1+075L2+075S1			1.000			
14	D1+075L2+075S2			1.000			
15	D1+075L2+075S3			1.000			
16	D1+06W3			1.000			
17	D1+06W8			1.000			
18	D1+06W9			1.000			
19	D1+045W3+075L1+075Lr1			1.000			
20	D1+045W3+075L2+075Lr1			1.000			
21	D1+045W3+075L1+075S1			1.000			
22	D1+045W3+075L1+075S2			1.000			
23	D1+045W3+075L1+075S3			1.000			
24	D1+045W3+075L2+075S1			1.000			
25	D1+045W3+075L2+075S2			1.000			
26	D1+045W3+075L2+075S3			1.000			
27	06D1+06W1			1.000			
28	06D1+06W2			1.000			
29	06D1+06W4			1.000			

Member Forces Summary

Table indicates Member ID, max CSL, max axial force, (max comp. force if different from max axial force)

TChd	19-1	0.181	382 lbs	(-346 lbs)	3-4	0.335	-1,280 lbs	6-7	0.336	-1,285 lbs	9-20	0.181	382 lbs	(-346 lbs)	
	1-2	0.036	-228 lbs		4-5	0.184	-651 lbs	7-8	0.464	-1,915 lbs					
	2-3	0.463	-1,910 lbs		5-6	0.185	-656 lbs	8-9	0.637	-2,293 lbs					
BChd	10-11	0.664	2436 lbs	(-2433 lbs)	12-13	0.335	1,367 lbs	14-15	0.178	689 lbs	(-685 lbs)	16-17	0.518	2,057 lbs	(-2,053 lbs)
	11-12	0.516	2051 lbs	(-2047 lbs)	13-14	0.176	683 lbs	15-16	0.336	1,373 lbs	(-1,369 lbs)	17-18	0.665	2,443 lbs	(-2,439 lbs)
webs	1-18	0.877	-996 lbs		4-15	0.097	-291 lbs	7-12	0.086	-267 lbs					
	2-17	0.068	-214 lbs		5-14	0.072	-206 lbs	8-11	0.068	-214 lbs					
	3-16	0.086	-267 lbs		6-13	0.097	-291 lbs	9-10	0.078	-267 lbs					

Additional Notes:

The end of every chord segment shall be braced laterally perpendicular to the plane of the truss. Lateral braces shall be installed within 6" of the end of each chord segment.
 NOTE : Web crippling calculation assume truss is fastened to support.

Structural diagram of a roof truss system with the following dimensions and labels:

- SPAN**: 18-2-4
- PITCH**: 4/12
- QTY**: 7
- OHL**: 2-3-4
- OHR**: 2-3-4
- PLYS**: 1
- SPACING**: 48 in
- WGT/PLY**: 80.5 lbs

Dimensions (inches):

- 2-3-4, 1-6-2
- 2-11-9, 2-11-9
- 3-0-13, 6-0-5
- 3-0-13, 9-1-2
- 3-0-13, 12-1-15
- 3-0-13, 15-2-11
- 2-11-9, 18-2-4
- 2-3-4, 1-6-2

Labels:

- KTP22-54
- KTP10-54
- KTP10-54
- KTP10-54
- KTP6-54
- KTP6-54
- KTP6-84

Dimensions at the bottom:

- 0-090-0, 0-4-12, 2-6-13, 0-4-12, 2-11-9
- 3-0-13, 6-0-5
- 3-0-13, 9-1-2
- 2-10-13, 12-1-15
- 3-0-13, 15-2-11
- 3-0-13, 17-9-8
- 2-6-13, 18-2-4
- 0-090-0, 0-4-12

Circle indicates fastener per unit width. Squares indicate fastener count in holes. "Fastener" indicates the number of 10/32" (AS1) fasteners required at one end of the member. Each value indicates the number of fasteners required. Where connection plates are called out on this drawing, a plate is required. Refer to General Notes for further clarifications. All fasteners shall be A307 grade 5. Maintain fastener edge spacing at 9 1/16" max. Maintain fastener edge margin at 9 1/16" max for each sheet of steel connected.

CSI Summary

CS Summary	Description	L	(loc)	Allowed
TC : 0092(5-6)	TL: 049in	L/434	12	L/ 240
BC : 0801(12-13)	LL: 023in	L/913	12	L/ 360
Web: 0693(4-12)	Cant/OHTL: 0.12inUP	2L/441	18	2L/ 180
	Cant/OHLL: 0.04inUP	2L/ 99	17	2L/ 180
	HzL TL: 036in		8	

Reaction Summary

Fictional Summary		Brg Combo	BrgWidth	Max React	Grav Uplift	MWFRSUplift	Max Uplift	Max Horiz
16	Pin(WL)	1	35in	1,790lbs			131lbs	

Material Summary

Material Summary		TChd	TChd Bracing Sheathed
		BChd	BChd Bracing 108 in
Web	Flange		
1-16	362SI(62-43)(50ksi)	except:	
	250SI(62-33)(50ksi)	7-8	250SI(62-43)(50ksi)

GUSSET PLATES

leads summary

Loads Summary

- 1) This truss has been designed in accordance with IBC - 2018.
- 2) This truss has been designed for the effects due to standard loading of TC Live = 20 psf; TC Dead = 12 psf; BC Live = 0 psf; BC Dead = 8 psf at 48 ioc.
- 3) This truss has been designed for the effects due to wind loads in accordance with ASCE7-16, V = 110 mph, Exposure C. The building is Gable with Risk Category II, Mean Roof Height 20 ft, Overall Building Dimensions of 67 ft x 131 ft, Enclosure Class: Enclosed, CC Zone Width 6.7 ft. The left end vertical has been exposed to wind. The right end vertical has been exposed to wind. This truss is not an End Zone Truss. This truss is in a Hurricane Prone Region.
- 4) This truss has been designed for the effects of balanced and unbalanced snow loads in accordance with ASCE7-16, using a ground snow load of 5 psf and terrain category B. The exposure condition is Fully Exposed. The thermal condition is All Others ($C_t = 1.0$) with building category II ($I = 1.0$). The roof ventilation is Unknown with Roof R-Value Unknown. The roof slope is 4/12 and the surface type is All Others. This truss has not been designed to account for the effects of ice dams forming at the eaves.

Member Forces Summary

Member Forces Summary										Base indicates member's maximum force, (max grip force from their nominal load force)						
TChd	17-1 1-2	0.440 0.596	98lbs -2.596lbs	(0lbs)	2-3 3-4	0.922 0.856	-4,360lbs -4,366lbs	4-5 5-6	0.856 0.922	-4,366lbs -4,360lbs	6-7 7-18	0.596 0.440	-2,596lbs 98lbs	(0lbs)		
BChd	8-9 9-10	0.007 0.217	47lbs 61lbs	(-29lbs) (-26lbs)	10-11 11-12	0.390 0.801	2,546lbs 5,024lbs	(-249lbs) (-345lbs)	12-13 13-14	0.801 0.390	5,024lbs 2,546lbs	(-346lbs) (-65lbs)	14-15 15-16	0.345 0.029	124lbs -131lbs	(-123lbs)
Webs	1-16 1-14 2-14 2-13	0.433 0.503 0.375 0.353	-1,782lbs 2,433lbs -1,108lbs 1,709lbs	(-143lbs)	3-13 4-13 4-12 4-11	0.135 0.405 0.693 0.405	-401lbs -840lbs 3,352lbs -840lbs	5-11 6-11 6-10 7-10	0.135 0.353 0.375 0.503	-401lbs 1,709lbs -1,108lbs 2,433lbs	(-257lbs)	7-8	0.433	-1,782lbs		

Additional Notes:

The end of every chord segment shall be braced laterally perpendicular to the plane of the truss. Lateral braces shall be installed within 6" of the end of each chord segment. NOTE : Web crippling calculation assume truss is fastened to support.



5/14/2025

TruTek Framing Systems

 4001 Hwy 153
 Greenville, SC 29611
 864 999 2020

Truss: T03-S1

 24188
 JobID: Jackson County Airport
 Date: 5/14/2025 8:39:17 AM
 System: KeyTRUSS 6.113
 Page: 2 of 2
 Report: Eng Plot

SPAN 18-2-4	PITCH 4/12	QTY 1	OHL 2-3-4	OHR 2-3-4	PLYS 1	SPACING 52 in	WGT/PLY 127.2 lbs
7	D1+06 W8			1.000			
8	D1+06 W9			1.000			
9	D1+06 W10			1.000			
10	D1+06 W11			1.000			
11	D1+045 W3+0.75 Lrl			1.000			
12	D1+045 W10+0.75 Lrl			1.000			
13	D1+045 W11+0.75 Lrl			1.000			
14	D1+045 W3+0.75 Sl			1.000			
15	D1+045 W3+0.75 S2			1.000			
16	D1+045 W3+0.75 S3			1.000			
17	D1+045 W10+0.75 Sl			1.000			
18	D1+045 W10+0.75 S2			1.000			
19	D1+045 W10+0.75 S3			1.000			
20	D1+045 W11+0.75 Sl			1.000			
21	D1+045 W11+0.75 S2			1.000			
22	D1+045 W11+0.75 S3			1.000			
23	06 D1+06 W1			1.000			
24	06 D1+06 W2			1.000			
25	06 D1+06 W4			1.000			
26	06 D1+06 W10			1.000			
27	06 D1+06 W11			1.000			

Member Forces Summary

Table indicates Member ID, max CS, max axial force, (max comp. force if different from max axial force)

TCrd	25-1	0.273	1.393 lbs	(-1,327 lbs)	3-4	0.198	-2,107 lbs	6-7	0.306	-2,156 lbs	9-10	0.201	-1,662 lbs	
	1-2	0.599	-1.159 lbs		4-5	0.189	-2,064 lbs	7-8	0.189	-2,067 lbs	10-11	0.599	-1,159 lbs	
	2-3	0.201	-1,663 lbs		5-6	0.306	-2,159 lbs	8-9	0.198	-2,109 lbs	11-26	0.273	1,393 lbs	
BChd	12-13	0.546	-7,159 lbs		15-16	0.442	-4,280 lbs	18-19	0.141	-1,200 lbs	21-22	0.621	-5,895 lbs	
	13-14	0.694	-6,791 lbs		16-17	0.353	-2,742 lbs	19-20	0.353	-2,747 lbs	22-23	0.695	-6,793 lbs	
	14-15	0.624	-5,892 lbs		17-18	0.140	-1,200 lbs	20-21	0.442	-4,283 lbs	23-24	0.546	-7,162 lbs	
Webs	1-24	0.682	-3,851 lbs		4-20	0.372	-1,100 lbs	7-17	0.096	-286 lbs	10-14	0.820	-2,403 lbs	
	1-22	0.595	4,735 lbs	(-3,360 lbs)	4-19	0.592	-1,658 lbs	8-17	0.592	-1,659 lbs	11-14	0.595	4,737 lbs	
	2-22	0.818	-2,400 lbs		5-19	0.096	-286 lbs	8-16	0.373	-1,101 lbs	11-12	0.682	-3,851 lbs	
	2-21	0.340	1,644 lbs	(-851 lbs)	6-19	0.580	2,285 lbs	(-1,495 lbs)	9-16	0.462	1,616 lbs	(-1,300 lbs)		
	3-21	0.465	-1,372 lbs		6-18	0.228	-675 lbs	9-15	0.465	-1,372 lbs				
	3-20	0.461	1,614 lbs	(-1,297 lbs)	6-17	0.581	2,286 lbs	(-1,496 lbs)	10-15	0.340	1,644 lbs	(-850 lbs)		

Additional Notes:

The end of every chord segment shall be braced laterally perpendicular to the plane of the truss. Lateral braces shall be installed within 6" of the end of each chord segment.

NOTE : Web crippling calculation assume truss is fastened to support.

Multiple pinned bearings exist.

TruTek Framing Systems

 4001 Hwy 153
 Greenville, SC 29611
 864 999 2020

Truss: T03-S2

 24188
 JobName: Jackson County Airport
 JobID: 5/14/2025 8:36:48 AM
 Date: KeyTRUSS 6.113
 System: 2 of 2
 Page: Eng Plot

SPAN	PITCH	QTY	OHL	OHR	PLYS	SPACING	WGT/PLY
18-2-4	4/12	1	2-3-4	2-3-4	1	52 in	126.6 lbs
7	D1+06W8			1.000			
8	D1+06W9			1.000			
9	D1+06W10			1.000			
10	D1+06W11			1.000			
11	D1+045W3+0.75Lrl			1.000			
12	D1+045W10+0.75Lrl			1.000			
13	D1+045W11+0.75Lrl			1.000			
14	D1+045W3+0.75Sl			1.000			
15	D1+045W3+0.75S2			1.000			
16	D1+045W3+0.75S3			1.000			
17	D1+045W10+0.75Sl			1.000			
18	D1+045W10+0.75S2			1.000			
19	D1+045W10+0.75S3			1.000			
20	D1+045W11+0.75Sl			1.000			
21	D1+045W11+0.75S2			1.000			
22	D1+045W11+0.75S3			1.000			
23	06D1+06W1			1.000			
24	06D1+06W2			1.000			
25	06D1+06W4			1.000			
26	06D1+06W10			1.000			
27	06D1+06W11			1.000			

Member Forces Summary

Table indicates: Member ID, max CS, max axial force, (max comp. force if different from max axial force)


TCrd	25-1	0.273	1.393 lbs	(-1.327 lbs)	3-4	0.199	-2,166 lbs	6-7	0.302	-2,164 lbs	9-10	0.188	-1,687 lbs	
	1-2	0.584	-1.105 lbs		4-5	0.188	-2,089 lbs	7-8	0.189	-2,091 lbs	10-11	0.585	-1,105 lbs	
	2-3	0.188	-1.687 lbs		5-6	0.302	-2,167 lbs	8-9	0.199	-2,168 lbs	11-26	0.273	1.393 lbs	
BChd	12-13	0.547	-7,174 lbs		15-16	0.435	-4,255 lbs	18-19	0.142	-1,253 lbs	21-22	0.624	-5,829 lbs	
	13-14	0.699	-6,804 lbs		16-17	0.345	-2,722 lbs	19-20	0.345	-2,727 lbs	22-23	0.699	-6,806 lbs	
	14-15	0.627	-5,826 lbs		17-18	0.141	-1,253 lbs	20-21	0.435	-4,258 lbs	23-24	0.547	-7,176 lbs	
Webs	1-24	0.672	-3,819 lbs		4-20	0.347	1,040 lbs	(-1,032 lbs)	7-17	0.095	-284 lbs	10-14	0.784	-2,313 lbs
	1-22	0.583	4,682 lbs	(-3,306 lbs)	4-19	0.585	-1,643 lbs		8-17	0.385	-1,644 lbs	11-14	0.584	4,684 lbs
	2-22	0.783	-2,310 lbs		5-19	0.095	-284 lbs		8-16	0.348	1,041 lbs	(-1,033 lbs)	11-12	-3,819 lbs
	2-21	0.328	1,587 lbs	(-782 lbs)	6-19	0.552	2,257 lbs	(-1,434 lbs)	9-16	0.452	1,587 lbs	(-1,274 lbs)		
	3-21	0.438	-1,298 lbs		6-18	0.237	-704 lbs		9-15	0.438	-1,299 lbs			
	3-20	0.451	1,585 lbs	(-1,271 lbs)	6-17	0.553	2,259 lbs	(-1,436 lbs)	10-15	0.328	1,587 lbs	(-782 lbs)		

Additional Notes:


The end of every chord segment shall be braced laterally perpendicular to the plane of the truss. Lateral braces shall be installed within 6" of the end of each chord segment.

NOTE : Web crippling calculation assume truss is fastened to support.

Multiple pinned bearings exist.

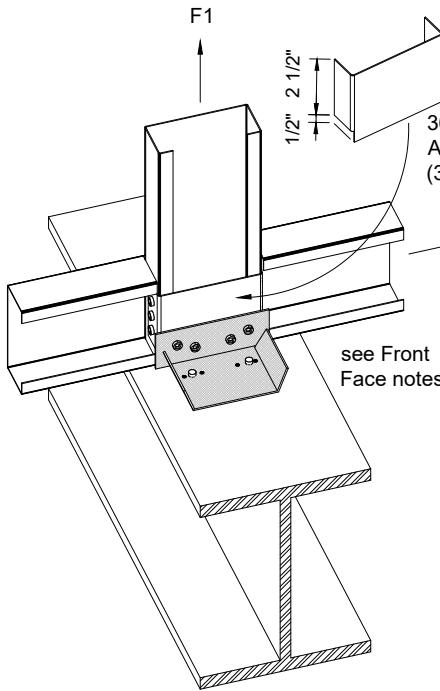

Back Face application
(if/as required)

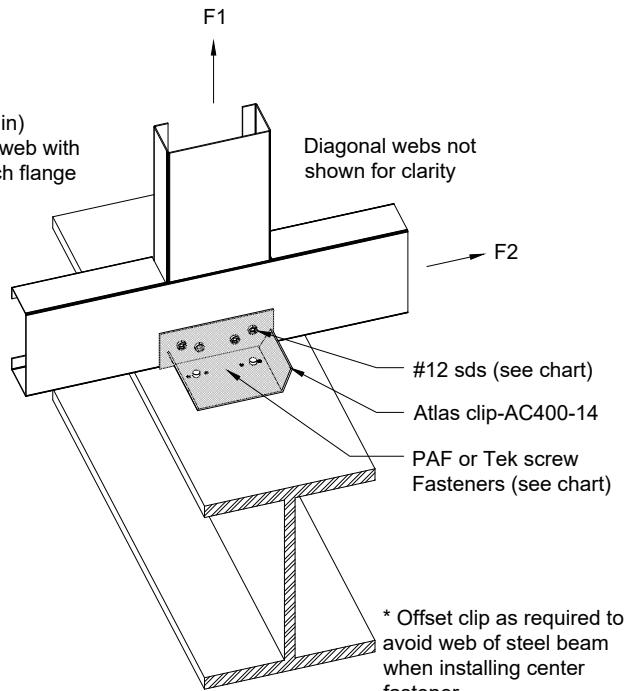

Front Face application
(typical)

AC400 Clip to Steel Connection Chart											
F1 [Front or Back Face]		AC400-14				Truss	AC400-12				Truss
		3/16"	1/4"	3/8"	1/2"		3/16"	1/4"	3/8"	1/2"	
Hilti X-U 0.157	2	942	948	948	948	4	942	1343	1343	1343	5
	3	n/a	n/a	n/a	n/a	n/a	1343	1343	1343	1343	5
#12 Tec	2	942	948	948	948	4	1343	1343	1343	1343	5
	3	n/a	n/a	n/a	n/a	n/a	1343	1343	1343	1343	5
F2 [Front Face]											
Hilti X-U 0.157	2	1924	1924	1924	1924	5 ¹	3468	3468	3468	3468	5 ³
	3	2886	2886	2886	2886	5 ³	3500	3500	3500	3500	5 ³
#12 Tec	2	1122	1122	1122	1122	5	1400	1400	1400	1400	4 ¹
	3	1683	1683	1683	1683	5 ¹	2100	2100	2100	2100	4 ²

¹ - Truss vertical at bearing to be 043 mil minimum.

² - Truss vertical at bearing to be 054 mil minimum.

³ - Truss vertical at bearing to be 068 mil minimum.

F2 [Back Face]			
All Bearings ¹		All AC Clips	Truss #12 sds
Truss Vertical	033	184	2
	043	302	2
	054	480	2

¹ - Minimum connection to bearing as shown above.

General Notes:

- Fasteners to be installed per manufacturer recommendations or AISI Standard. Install screws/PAF's/anchors to bearing support through holes or location marks in large leg of connector.
- Equivalent fasteners may be substituted for those specified.
- Welding per ASW (D1.1)
- Detail follows AISI S100 and S240:
 - Minimum SDS spacing = 5/8"
 - SDS shear and tension values based on AISI S100-16.
 - Minimum PAF spacing = 1"
 - Weld transverse and longitudinal strength values per AISI S100-16.
- Supports shown do not represent or imply approved design.
- If Detail is applied to both faces of a truss vertical then front face and back face chart values may be added together.
- Allowable loads have not been increased for wind or seismic.
- Max. reactions shown are non-concurrent.



2/28/2025

JOB NAME:
LOCATION:

TruTek
Framing Systems LLC



ISSUE DATE:
02/27/25

REVISIONS:

TruTek Job# 24188

Drawn By: ADT


Approved By: JM

TB1.0

FULL MOON
ENGINEERING

1.75"x5" 97 mil Flat Plate
-Attach to truss with (11) #12 sds as shown.
-Attach to structural steel with weld as shown

Max reaction: 7,200 lbs.

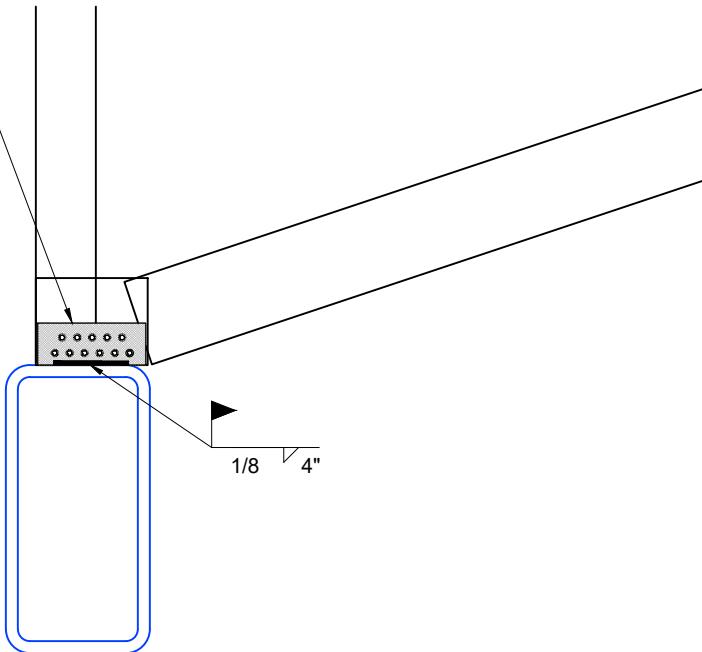

FULL MOON
ENGINEERING

Jackson County Airport Terminal
Jefferson, GA

JOB NAME:
LOCATION:

TruTek
Framing Systems LLC

ISSUE DATE:
02/27/25


REVISIONS:

05/14/25

TruTek Job# 24188
Drawn By: ADT
Approved By: JM

General Notes:

1. Fasteners to be installed per manufacture recommendations or AISI Standard.
2. Equivalent fasteners may be substituted for those specified.
3. Welding per ASW (D1.1)
4. Detail follows AISI S100 and S240:
 - a. Minimum SDS spacing = 5/8"
 - b. SDS shear and tension values based on AISI S100-16.
 - c. Weld transverse and longitudinal strength values per AISI S100-16.
5. Supports shown do not represent or imply approved design.
6. Allowable loads have not been increased for wind or seismic.
7. Max. reactions shown are non-concurrent.

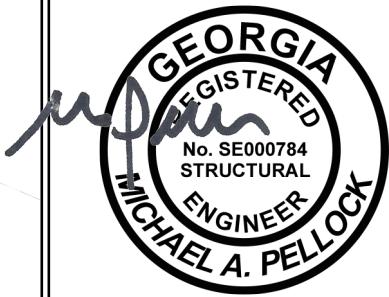


5/14/2025


TB1.1

BENT PLATE SCHEDULE (figured with 6" overlaps)

QTY	LABEL	Ga.	LENGTH	LEG (A)	LEG (B)	\angle°	PROFILE	DESCRIPTION
12	(RP3)	14	10'-0"	4"	4"	152	^	Ridge
9	(RP4)	14	10'-0"	4"	4"	144	^	Ridge
17	(FT4)	14	10'-0"	3"	3"	72	∨	Fascia-Top
26	(FT3)	14	10'-0"	4"	4"	76	∨	Fascia-Top
21	(BP90)	14	10'-0"	3"	3"	90	└	Rake
8	(DT90)	14	10'-0"	4"	4"	90	└	Deflection Track
18	(FP1)	14	10'-0"	8"		180	—	Flat Plate

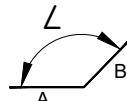
SHEAR BLOCKING PLATES

QTY	LABEL	Ga.	LENGTH	LEG (A)	LEG (B)	LEG (C)	$\angle^\circ(1)$	PROFILE	DESCRIPTION
58	(SB1)	12	3'-4"	2"	13.25"	5"	76	1	Shear Blocking
10	(SB2)	16	3'-4"	2"	6.75"	5"	72	1	Shear Blocking

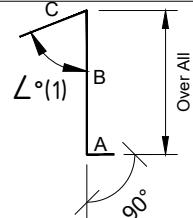
SEPARATE PRODUCTS LIST

CONNECTORS				DESCRIPTION			
QTY	LABEL	LENGTH	DETAIL	DESCRIPTION			
140	AC400-14	0'-4"	TB1.0	AC400 14g Atlas Truss-to-Bearing Clip			
10	1.75x500-12	0'-5"	TB1.1	1 3/4" x 5" 12ga Truss-to-Bearing Weld Plate			
110	AL362	0'-4"	BB1, BB2/BL1.0	AL362 Stiff Clip			
22	4x1.5x6-90°	0'-6"	SB3/BL1.0	4" x 1 1/2" x 6" Bent 90° 14ga clip			
22	4x1.5x6-108°	0'-6"	SB3/BL1.0	4" x 1 1/2" x 6" Bent 108° 14ga clip			

BRACING

QTY	LABEL	LENGTH	AREA	DESCRIPTION			
150	150F125-33	5'-0"	CONST	1 1/2" 20ga. Hat-Channel (figured at +/-10' on center)			
70	150F125-33	12'-6"	B.C.	1 1/2" 20ga. Hat-Channel (see BL1.0)			

MISCELLANEOUS

QTY	LABEL	LENGTH	DETAIL	DESCRIPTION			
25	OL1	5'-9 1/2"	OUTLKR	600S162-43 Outlooker			
16	OL2	6'-4 3/4"	OUTLKR	362S162-43 Outlooker			
8	OL3A	2'-1 1/4"	OUTLKR	600S162-43 Outlooker			
8	OL3B	6'-8 1/2"	OUTLKR	600S162-43 Outlooker			
12	OL362	3'-10"	OUTLKR	362S162-43 Blocking between outlookers			
34	OL600	3'-10"	OUTLKR	600S162-43 Blocking between outlookers			
9	362T125-43	10'-0"	OUTLKR	Cap Track (each end of Outlookers)			
30	600T125-43	10'-0"	OUTLKR	Cap Track (each end of Outlookers)			
100	3x1.5x2.5-18	0'-2 1/2"	OUTLKR	18ga. Clips (each end of Outlooker Blocking)			
16	AL362	0'-4"	4, 8/TL2.0	AL362 Stiff Clip - Outlooker to beam Connection			
10	250S162-43	10'-0"	SB3/BL1.0	2 1/2" 18ga C-stud shear blocking			
10	200STRAP	10'-0"	SB3/BL1.0	2" Wide 18ga. Flat Strap			
32	362S162-43	12'-0"	BB1, BB2/BL1.0	3 5/8" 18ga diagonal and lateral C-stud bracing			
40	HGB8BPO-12X112	0'-1 1/2"	3/TL2.0	1 1/2"-13 x 1 1/2" Conquest Grade 8 Flange Bolt			
40	HNG2-12HDG		3/TL2.0	1 1/2"-13 Conquest Grade 2 Hex Nut			
40	ABW12-HDG		3/TL2.0	1 1/2" Conquest USS Flat Washer			
60	SC62-5/97-KT25		3/TL2.0	Simpson SC62-5/97 Slide-Clip			

JOB NAME:

Jackson County Airport Terminal

LOCATION:

ISSUE DATE:

02/27/2025

REVISIONS:

05/14/25

TruTek Job# 24188

Drawn By: ADT

Approved By: JM

SP1.0