



10641 Highway 36
Covington, GA
30014

www.sunbeltbuilders.com

t 770.786.3031
f 770.786.3046


JACKSON COUNTY AIRPORT TERMINAL BUILDING

Twelve & Associates
2270 Northwest Parkway,
Suite 185
Marietta, GA 30067
ph: 770-953-8585
John Jolley
jjolley@12assoc.com

27-2000 Communications As-built

—

Claude Dixon
Claude Dixon
LVU000691

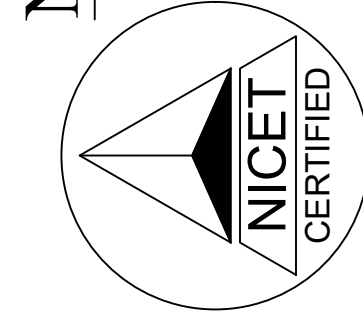

NICET III CERTIFICATE

Dennis James Hoffman Jr.

CERT. NO. - 148204

Dennis J. Hoffman

ICET III CERTIFICATE
Dennis James Hoffman Jr.
CERT. NO. - 148204
VALID THRU 09-01-27
Dennis J. Hoffman

AS - BUILT DRAWING

DATE: 12/29/2025
PW

DATA SYMBOL LEGEND					
QTY.	SYM.	MANUFACTURER	MODEL	DESCRIPTION	INSTALLATION
22	▽	DATA COM		SINGLE DATA DROP	20-3001-IV 1 PORT IVORY PLATE
24	▽	DATA COM		DOUBLE DATA DROP	20-3002-IV 2 PORT IVORY PLATE
1	DATA1	VERTICAL CABLE	043-384/48/2U	48 PORT PATCH PANEL	
1	DATA2	VERTICAL CABLE	043-382/24/1U	24 PORT PATCH PANEL	

WIRE LEGEND			
WIRE	COND	A.W.G.	TYPE DESCRIPTION
A			
B			
C			WAVENET CAT6 CAT6 - VOICE AND DATA

DATA SYMBOL LEGEND

WIRE LEGEND

WIRE LEGEND			
WIRE	COND	A.W.G.	TYPE DESCRIPTION
A			
B			
C			WAVENET CAT6 CAT6 - VOICE AND DATA



SS - BUILT DRAWING
PW
12/29/2025
TE:
