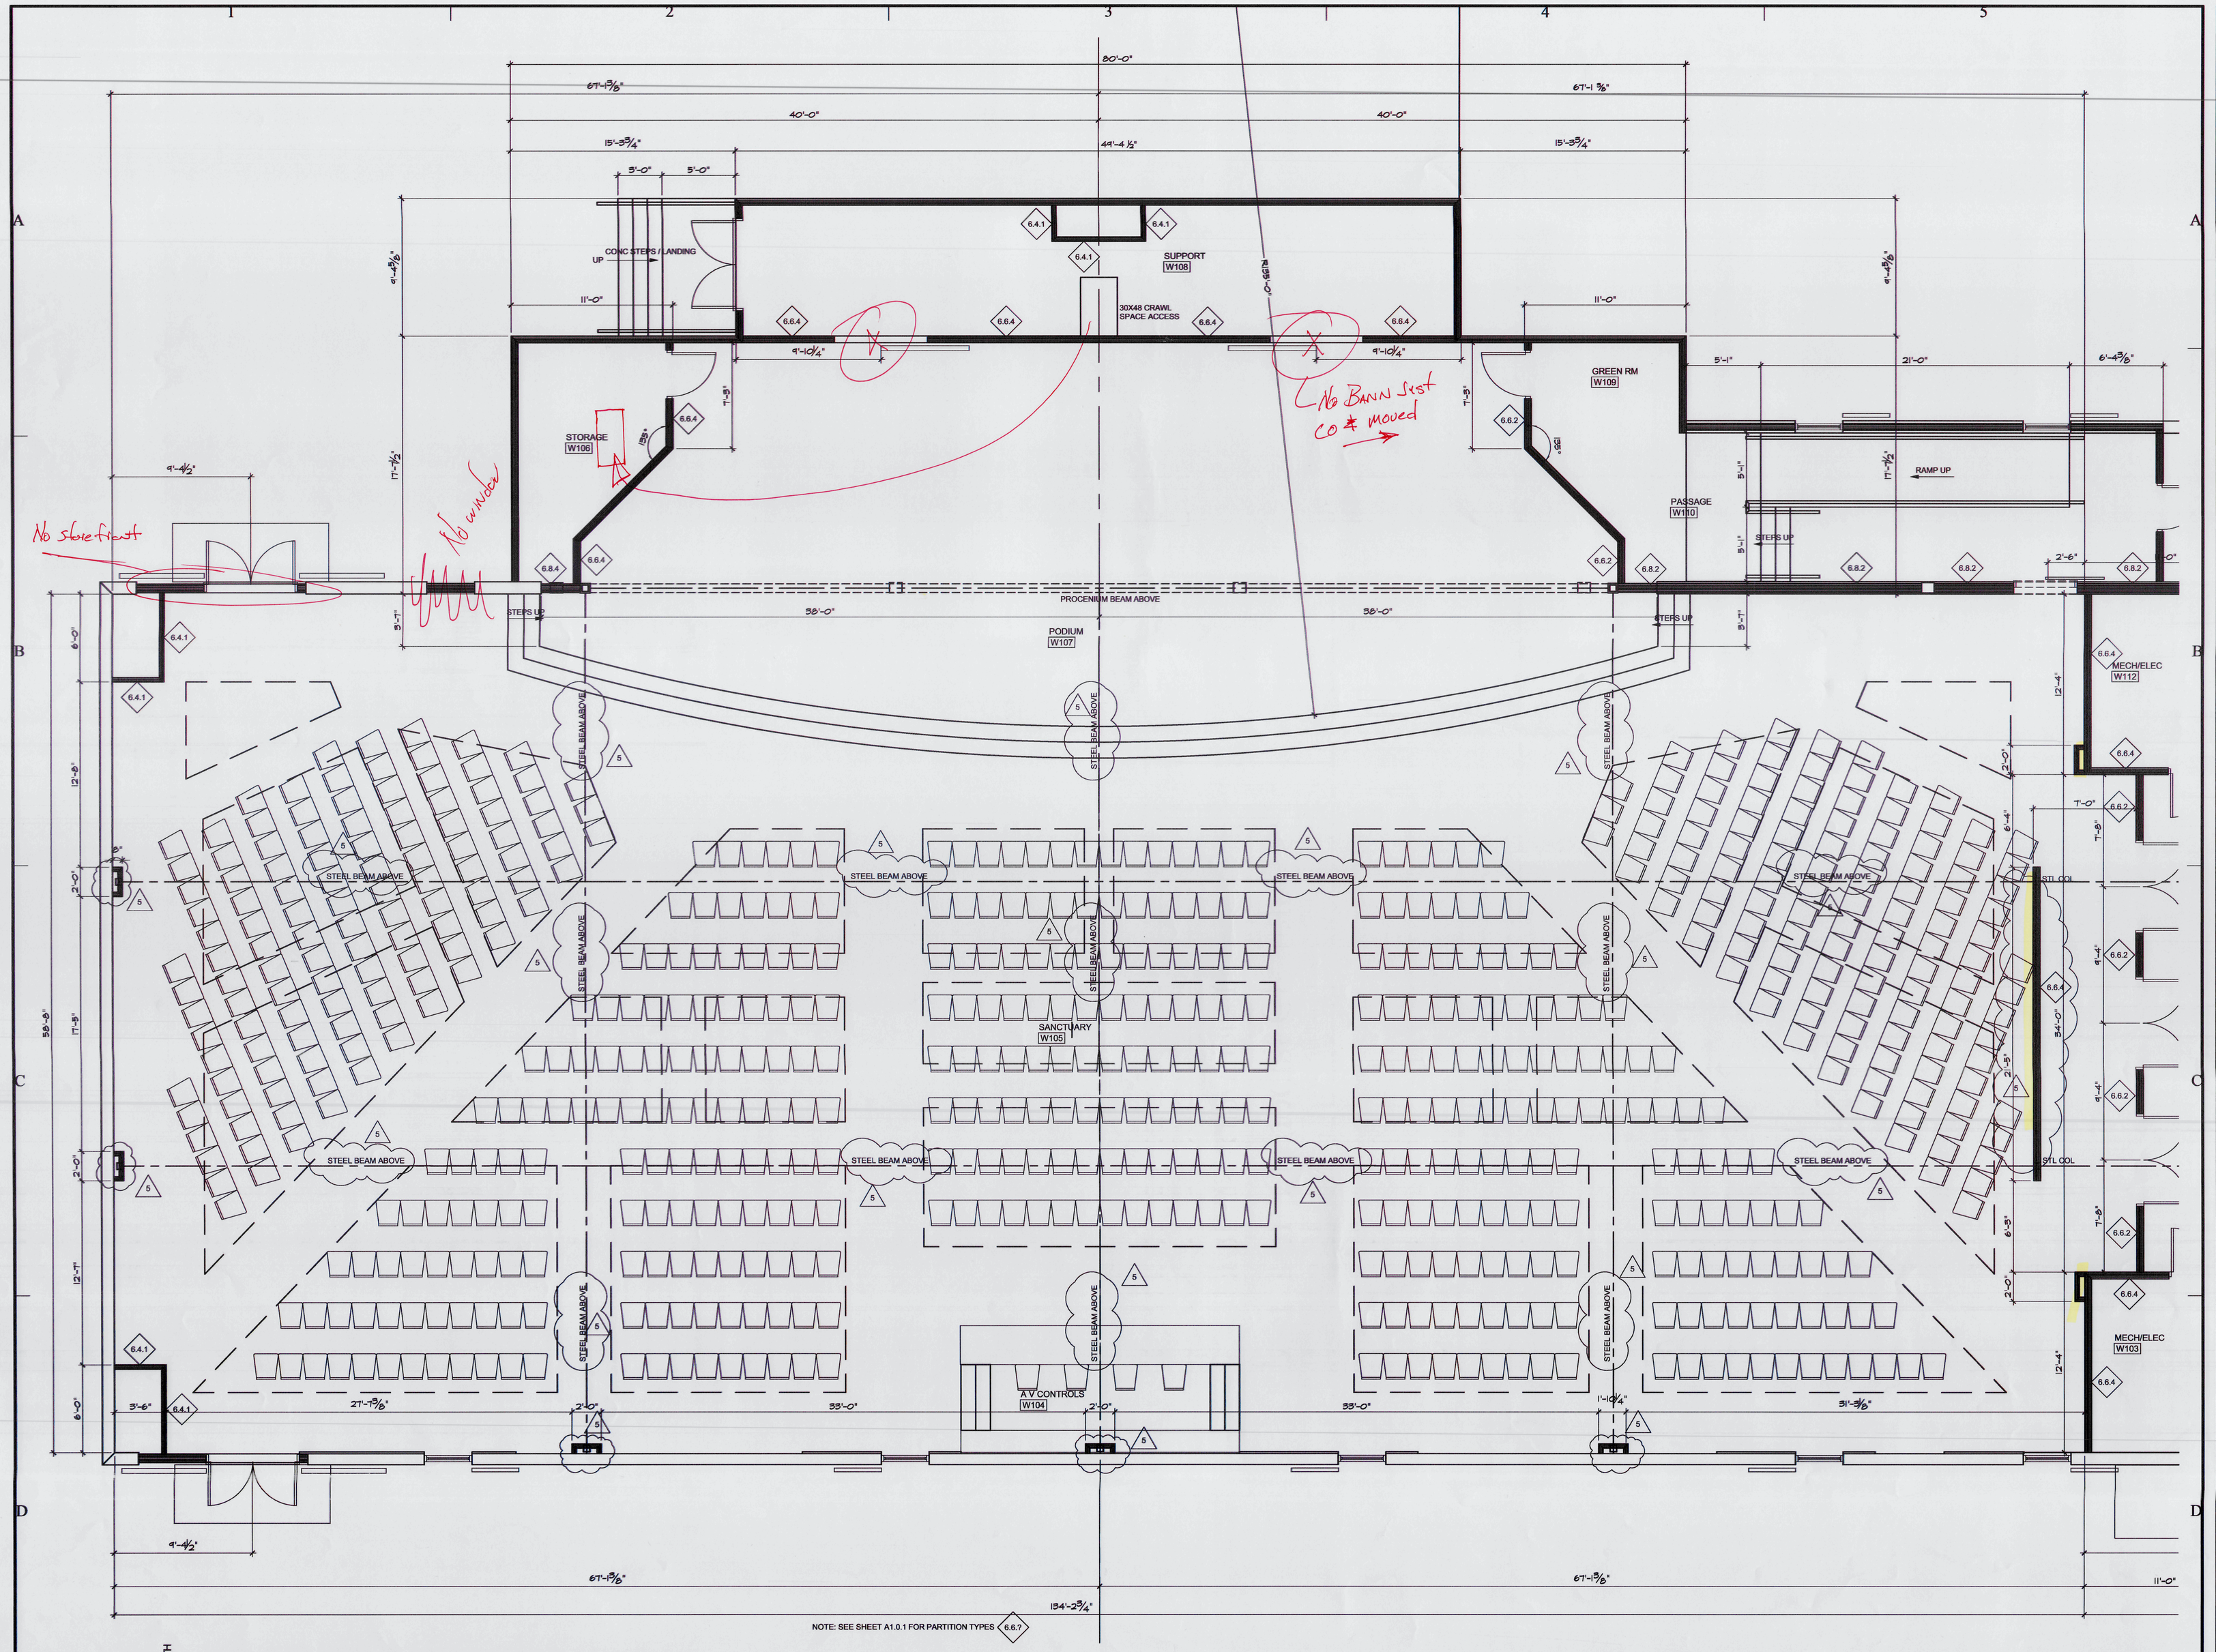

FIRST FLOOR PLAN: WORSHIP-PHASE I

SCALE: 1/4" = 1'-0"

D1
A1.1.1

GM
Architect
102 Sammy Court
WARNER ROBINS, GEORGIA 31088
glmarch@outlook.com
(478)-365-8976

ARCHITECT

STATE OF GEORGIA
GARY L. MCNUTT
CERTIFICATE NO. 2010
REGISTERED ARCHITECT
STAMP INVALID UNLESS SIGNED

CONSULTANT

STAMP INVALID UNLESS SIGNED

SUNBELT BUILDERS
10641 HIGHWAY 36
COVINGTON, GA 30014
770.786.3031

FIRST FLOOR PLAN

Retrofit & Renovations for Madison Methodist Church

1091 Confederate Highway
Madison, Georgia 30650

JOB NO.:	02405
DRAWN BY:	GM
CHECKED BY:	GM
DESCRIPTION:	SCH-REVIEW-P1
DATE:	08.04.24
DESCRIPTION:	DD-REVIEW
DATE:	00.00.24
DESCRIPTION:	CD-REVIEW
DATE:	01.02.25
DESCRIPTION:	BID-CONSTRUCTION
DATE:	01.21.25

REVISIONS:

1	03.24.25	8	
2	04.21.25	9	
3	08.11.25	10	
4	08.20.25	11	
5	09.03.25	12	
6	09.03.25	13	
7		14	

THESE DRAWINGS ARE THE PROPERTY OF GMarchitect AND ARE NOT TO BE REPRODUCED OR REUSED WITHOUT PERMISSION AND CREDIT.
COPYRIGHT: © 2025

SHEET

A1.1.1

OF