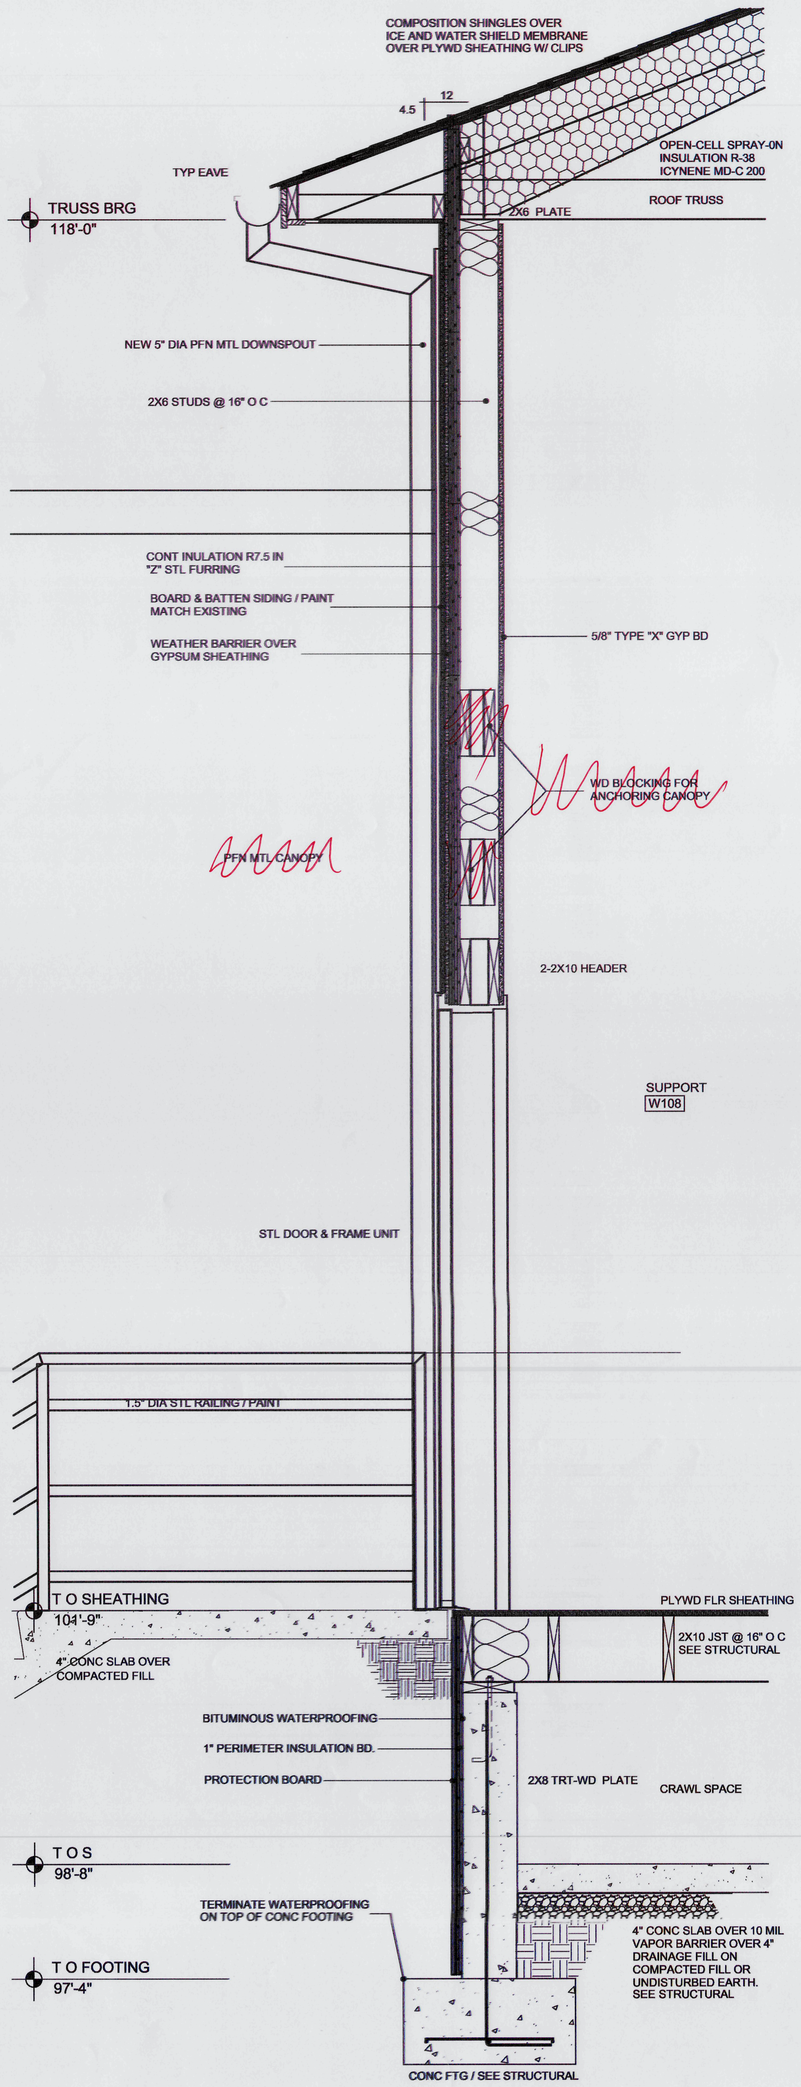

D1 A4.2 **WALL SECTION**

SCALE: 1"=1'-0"

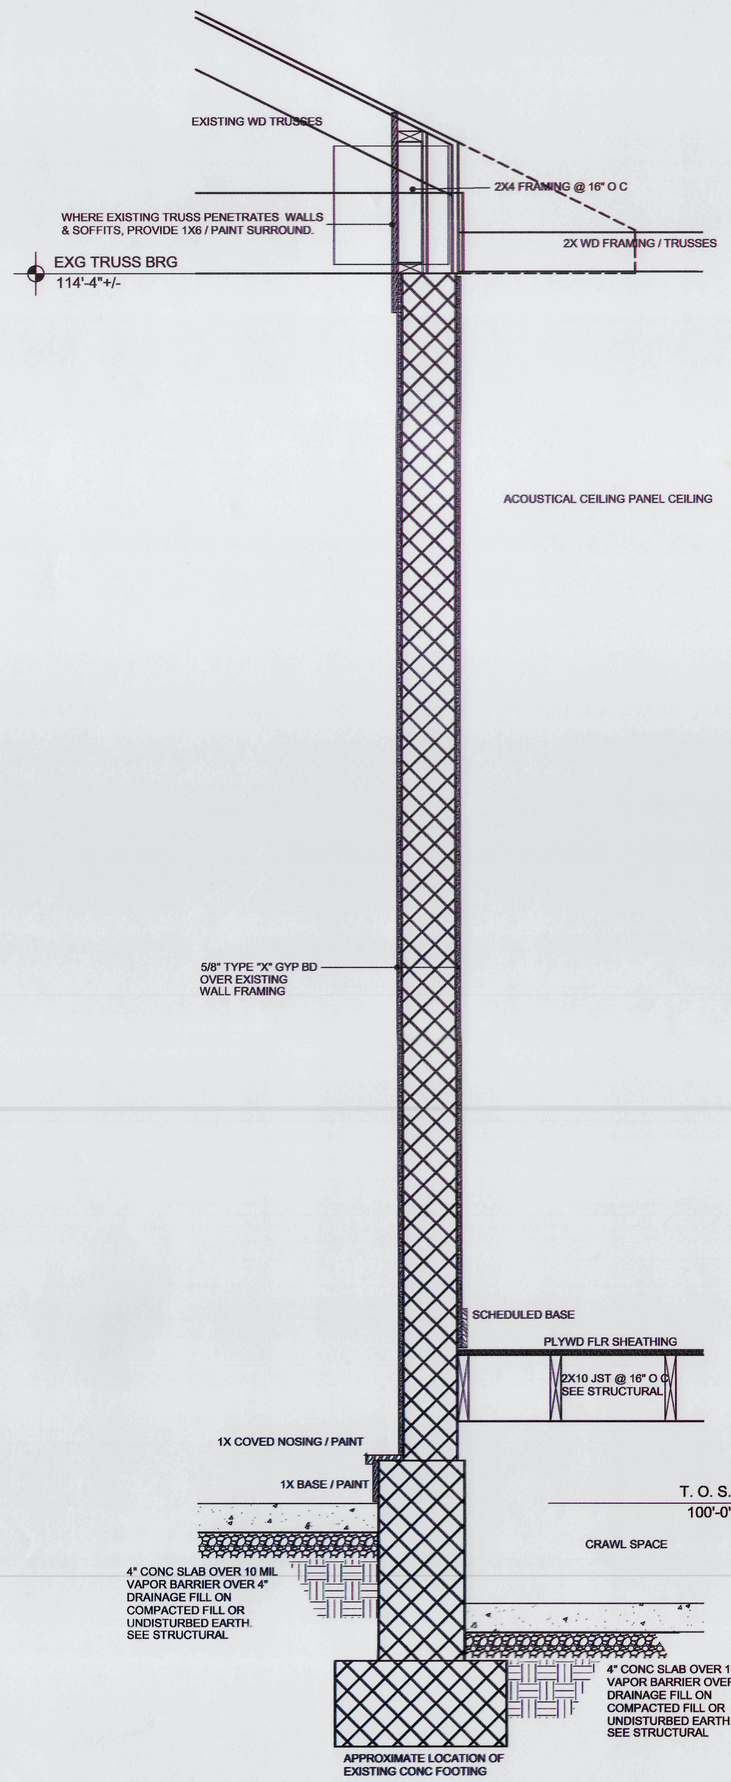

D2 A4.2 **WALL SECTION**

SCALE: 1"=1'-0"

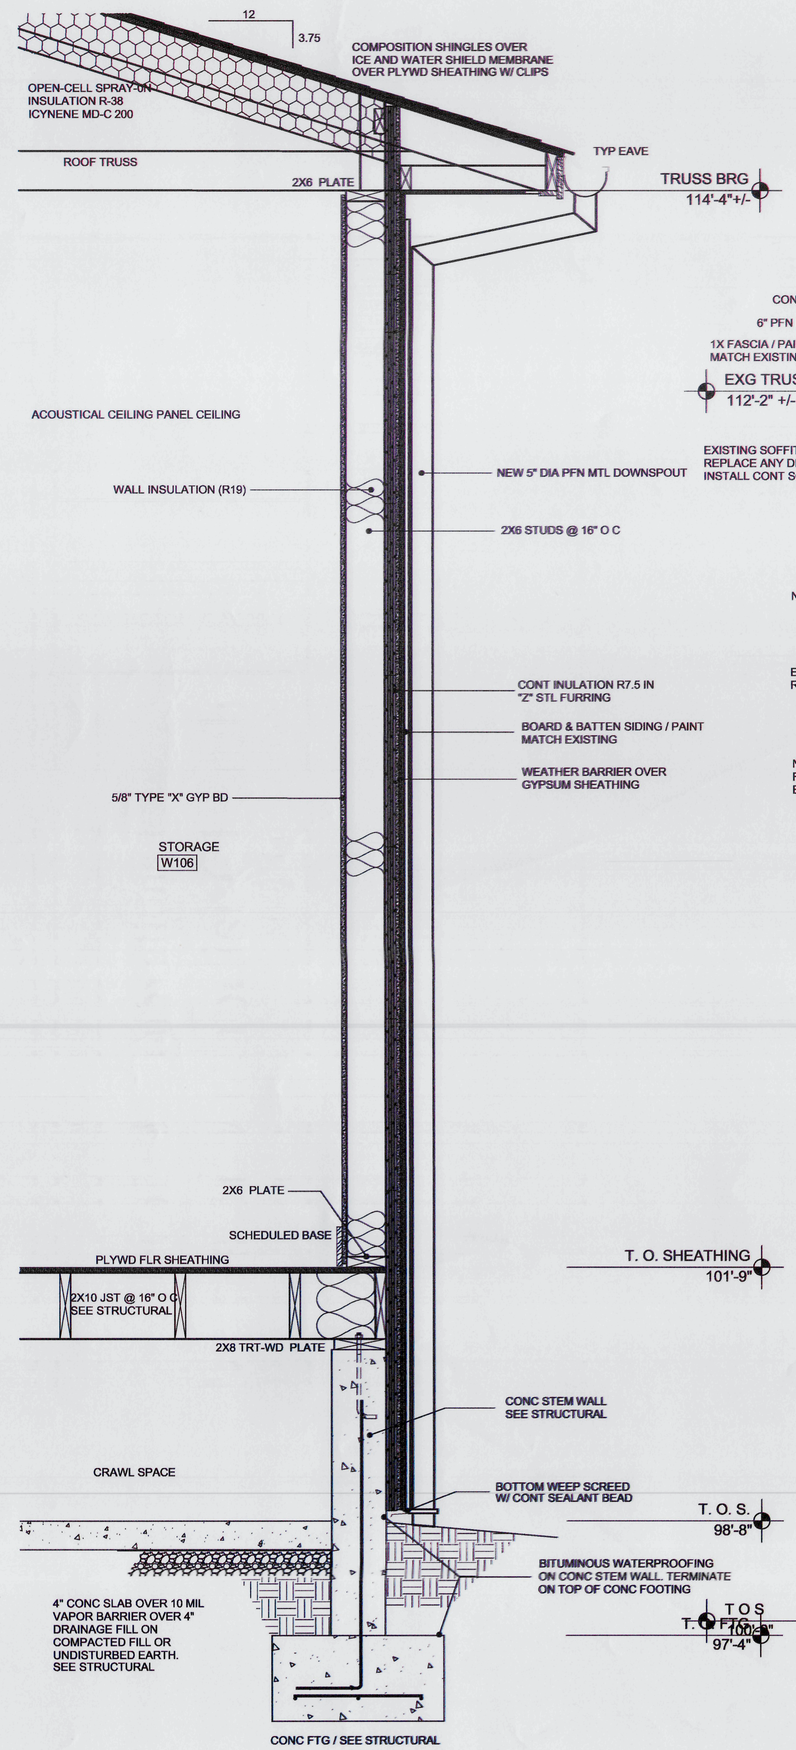

D4 A4.2 **WALL SECTION**

SCALE: 1"=1'-0"

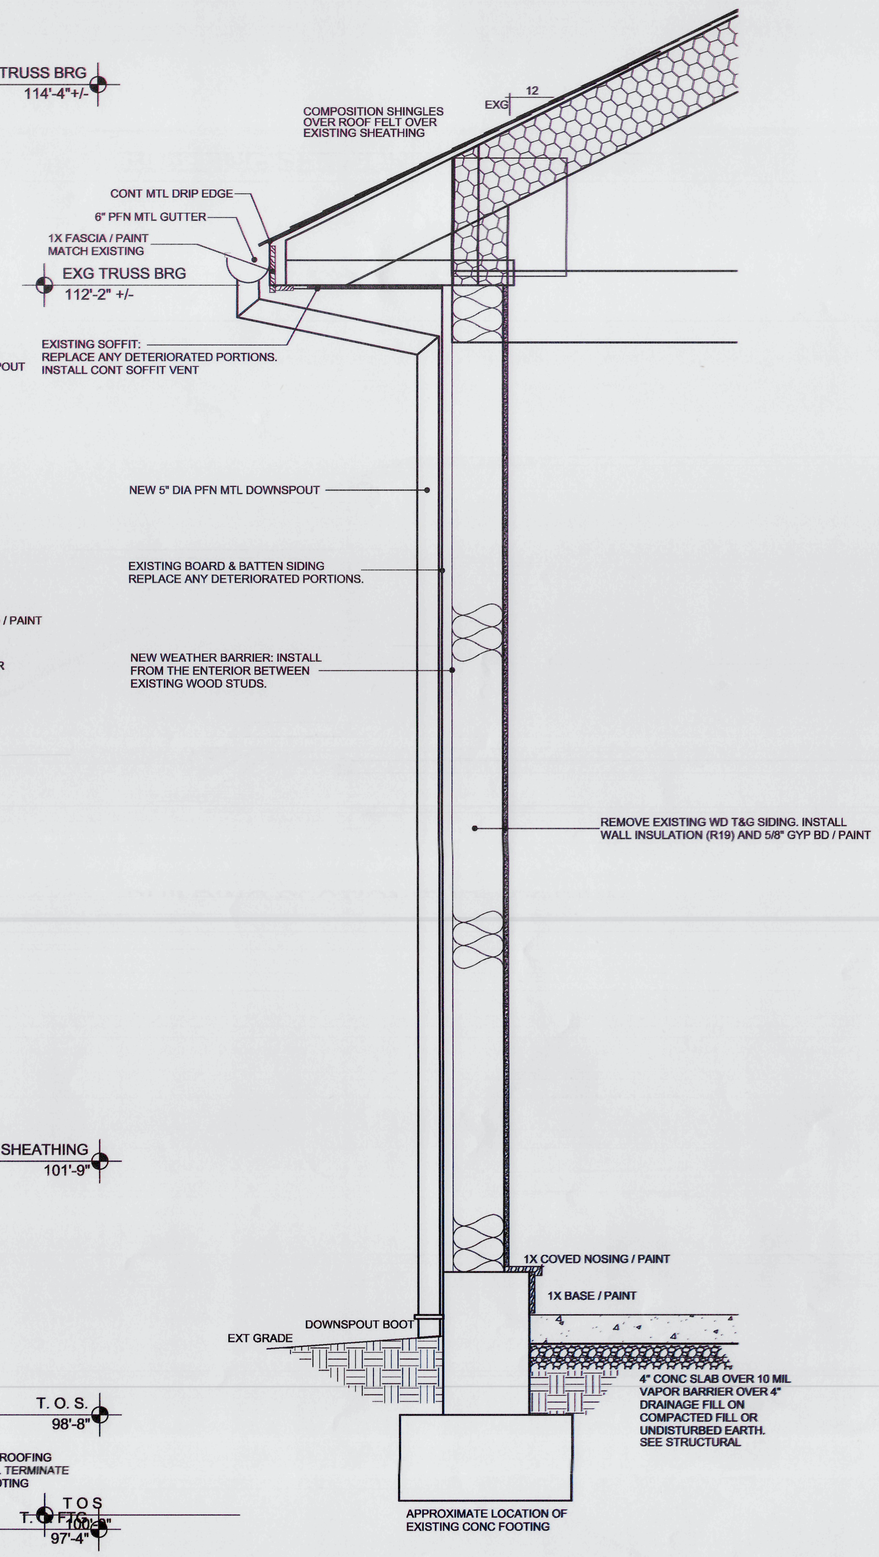

D5 A4.2 **TYP WALL SECTION: STABLES**

SCALE: 1"=1'-0"

GM
Architect
102 Sammy Court
WARNER ROBINS, GEORGIA 31088
glmarch@outlook.com
(478)-365-8976

ARCHITECT

STATE OF GEORGIA · GARY L. MCNUTT · CERTIFICATE NO. 0004 · REGISTERED ARCHITECT

STAMP INVALID UNLESS SIGNED

CONSULTANT

STAMP INVALID UNLESS SIGNED

SUNBELT BUILDERS

10641 HIGHWAY 36
COVINGTON, GA 30014
770.786.3031

WALL SECTIONS & DETAILS

Retrofit & Renovations for Madison Methodist Church

1091 Confederate Highway
Madison, Georgia 30650

JOB NO.:	02405
DRAWN BY:	GM
CHECKED BY:	GM
DESCRIPTION:	SCH-REVIEW-P1
DATE:	08.04.24
DESCRIPTION:	DD-REVIEW
DATE:	00.00.24
DESCRIPTION:	CD-REVIEW
DATE:	01.02.25
DESCRIPTION:	BID-CONSTRUCTION
DATE:	01.21.25

REVISIONS:

1	03.24.25	8	
2	04.21.25	9	
3	08.11.25	10	
4	08.20.25	11	
5	09.03.25	12	
6	12.19.25	13	
7		14	

THESE DRAWINGS ARE THE PROPERTY OF GMarchitect AND ARE NOT TO BE REPRODUCED OR REUSED WITHOUT PERMISSION AND CREDIT.
COPYRIGHT: © 2025

SHEET

A4.2

OF