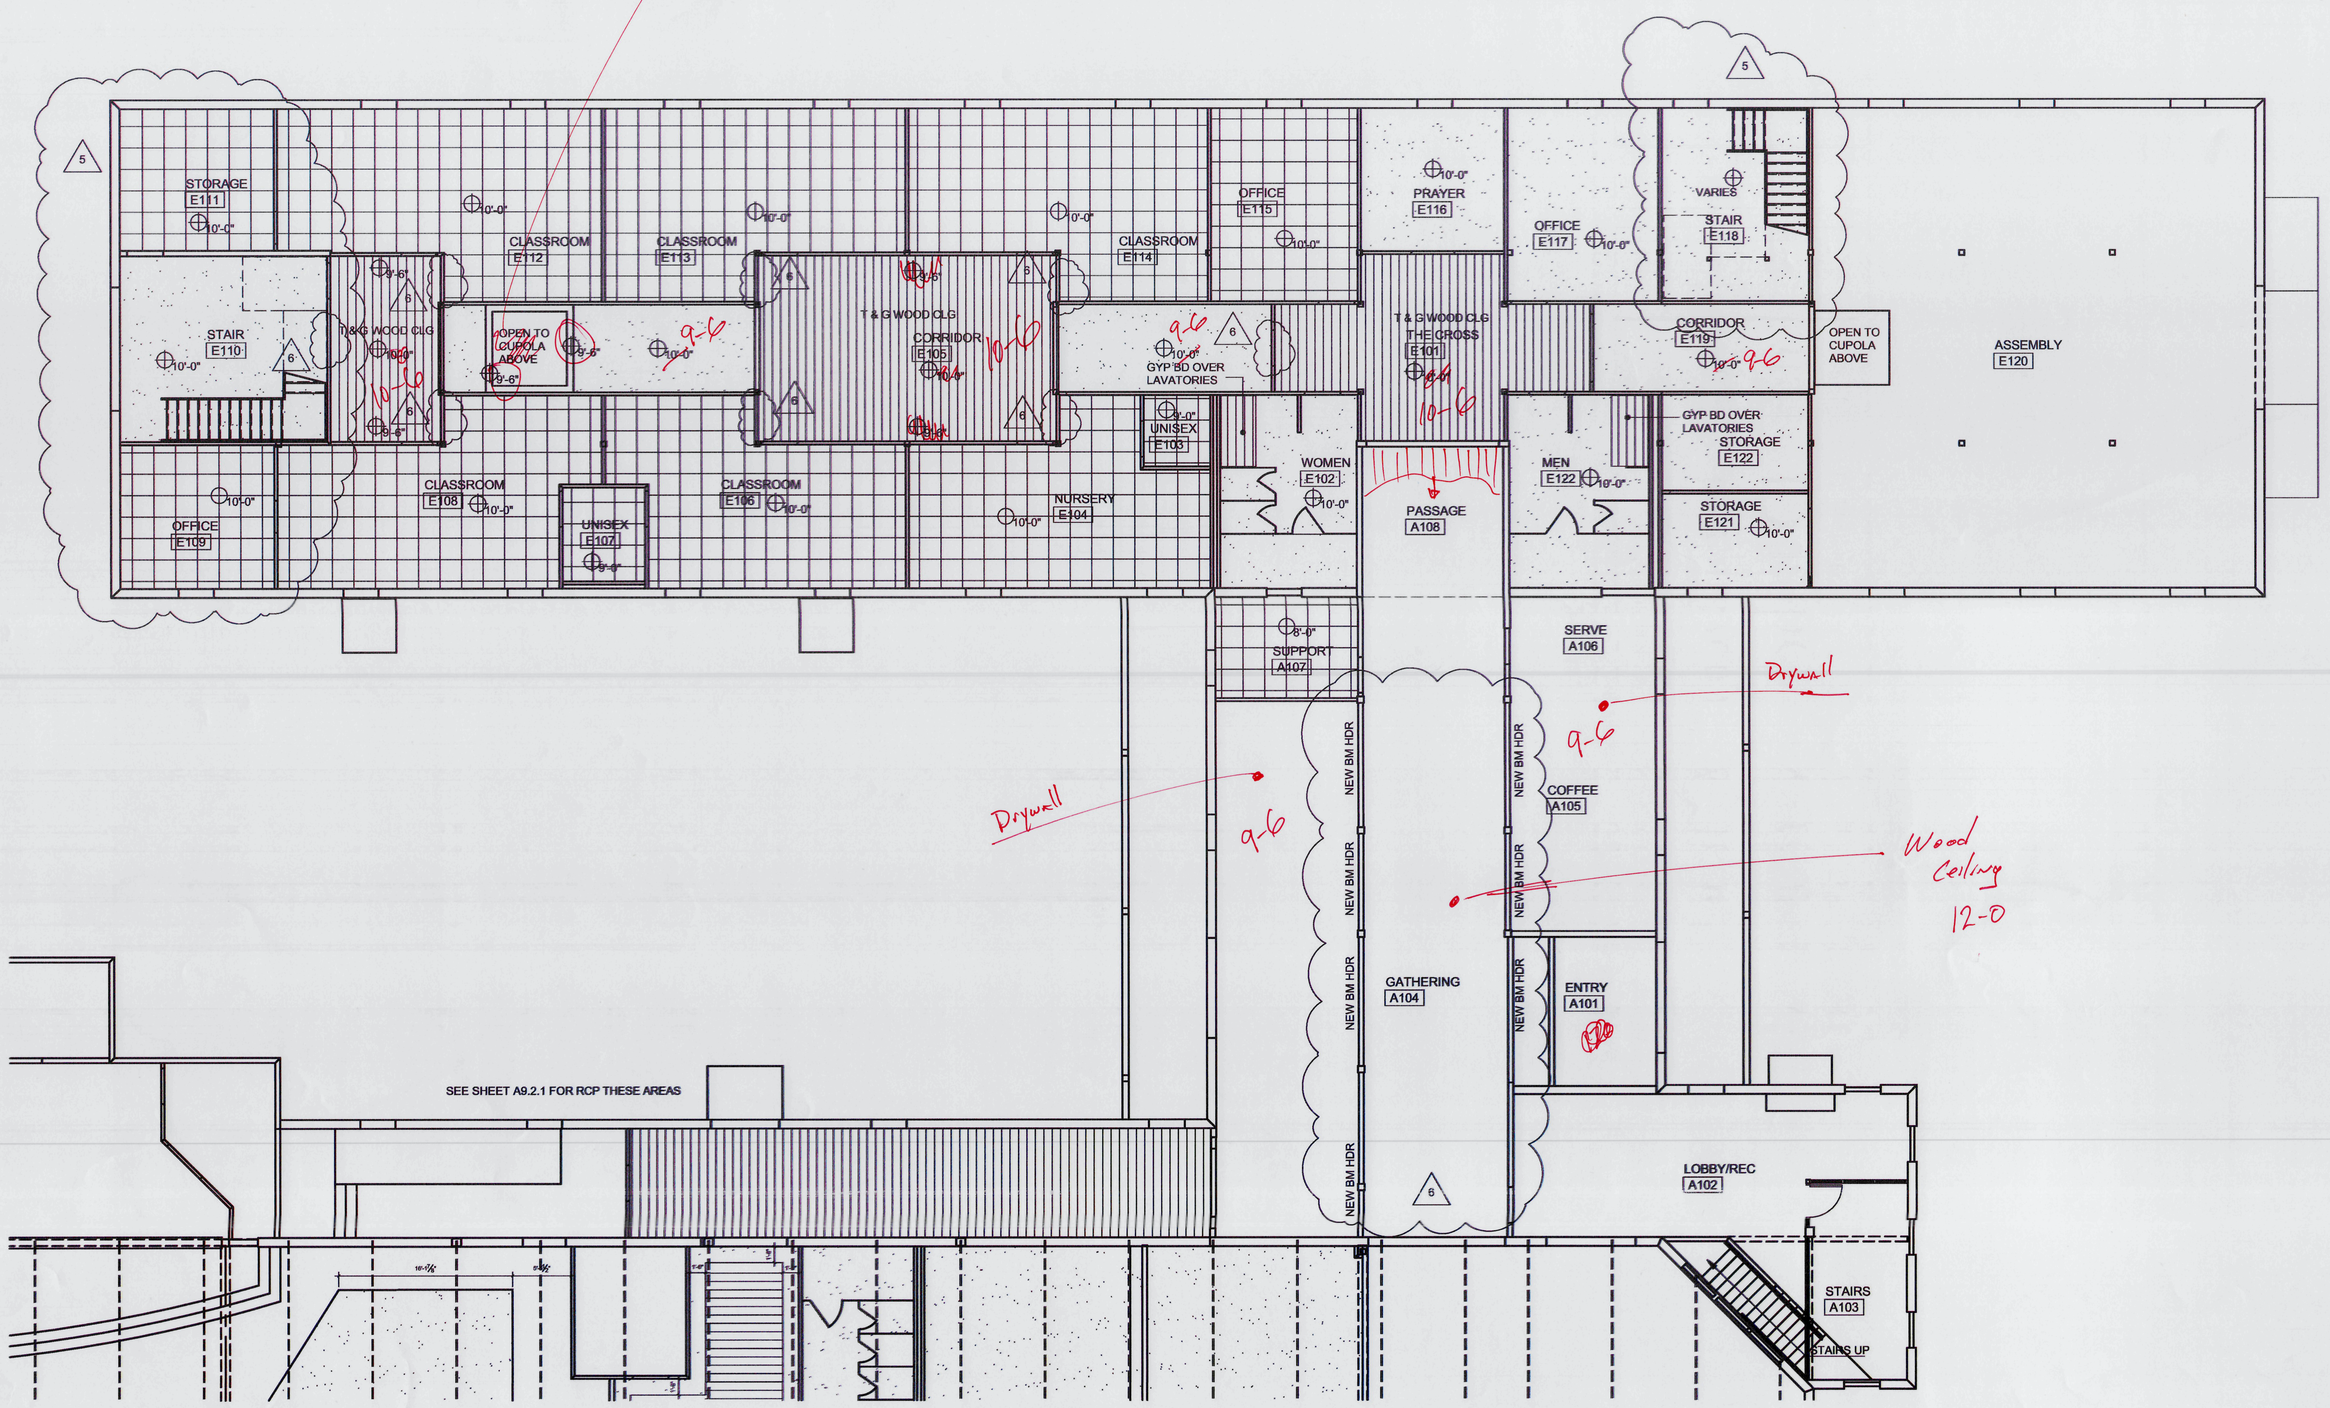

FIRST FLOOR PLAN: EDUCATION / GATHERING-PHASE I

SCALE: 1/8" = 1'-0"

SCALE IN FEET

GM Architect

102 Sammy Court
WARNER ROBINS, GEORGIA 31088
gmarch@outlook.com
(478)-365-8976

ARCHITECT

STATE OF GEORGIA · GARY L. MCNUTT · CERTIFICATE NO. 5880 · REGISTERED ARCHITECT

STAMP INVALID UNLESS SIGNED

CONSULTANT

STAMP INVALID UNLESS SIGNED

SUNBELT BUILDERS

10641 HIGHWAY 36
COVINGTON, GA 30014
770.786.3031

FINISH FLOOR PLAN, NOTES, & FINISH SCHEDULES

Retrofit & Renovations for Madison Methodist Church

1091 Confederate Highway
Madison, Georgia 30650

JOB NO.:	02405
DRAWN BY:	GM
CHECKED BY:	GM
DESCRIPTION:	SCH-REVIEW-P1
DATE:	08.04.24
DESCRIPTION:	DD-REVIEW
DATE:	00.00.24
DESCRIPTION:	CD-REVIEW
DATE:	01.02.25
DESCRIPTION:	BID-CONSTRUCTION
DATE:	01.21.25

REVISIONS:

1	03.24.25	8	
2	04.21.25	9	
3	08.11.25	10	
4	08.20.25	11	
5	09.03.25	12	
6	12.19.25	13	
7		14	

THESE DRAWINGS ARE THE PROPERTY OF GMarchitect AND ARE NOT TO BE REPRODUCED OR REUSED WITHOUT PERMISSION AND CONSENT.

COPYRIGHT: © 2025

SHEET

A9.2.2

OF